



画地出来形図

S = 1 : 250

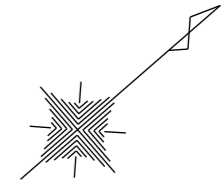



四街道市
たかおの杜

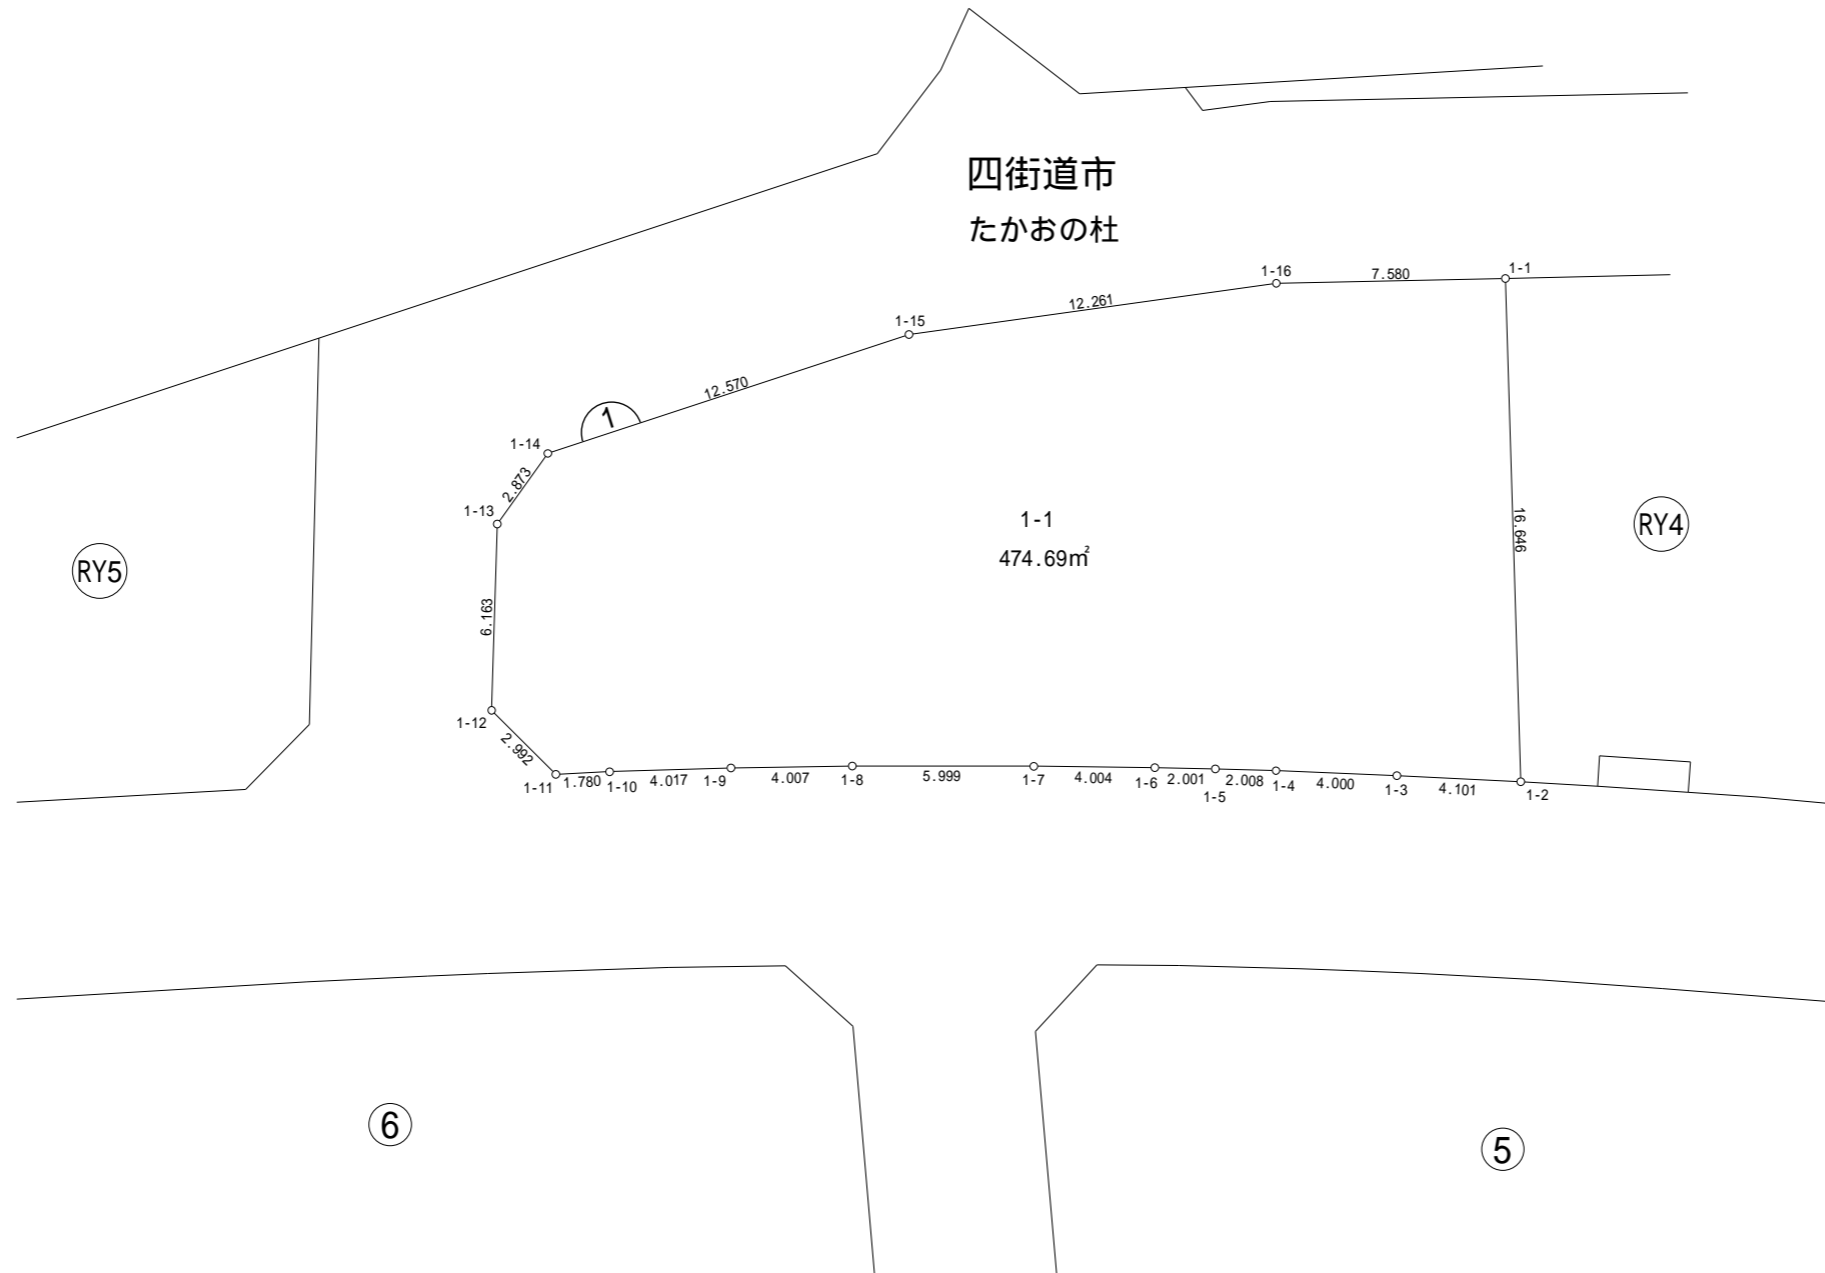

画地出来形図

S = 1 : 500



四街道市
たかおの杜

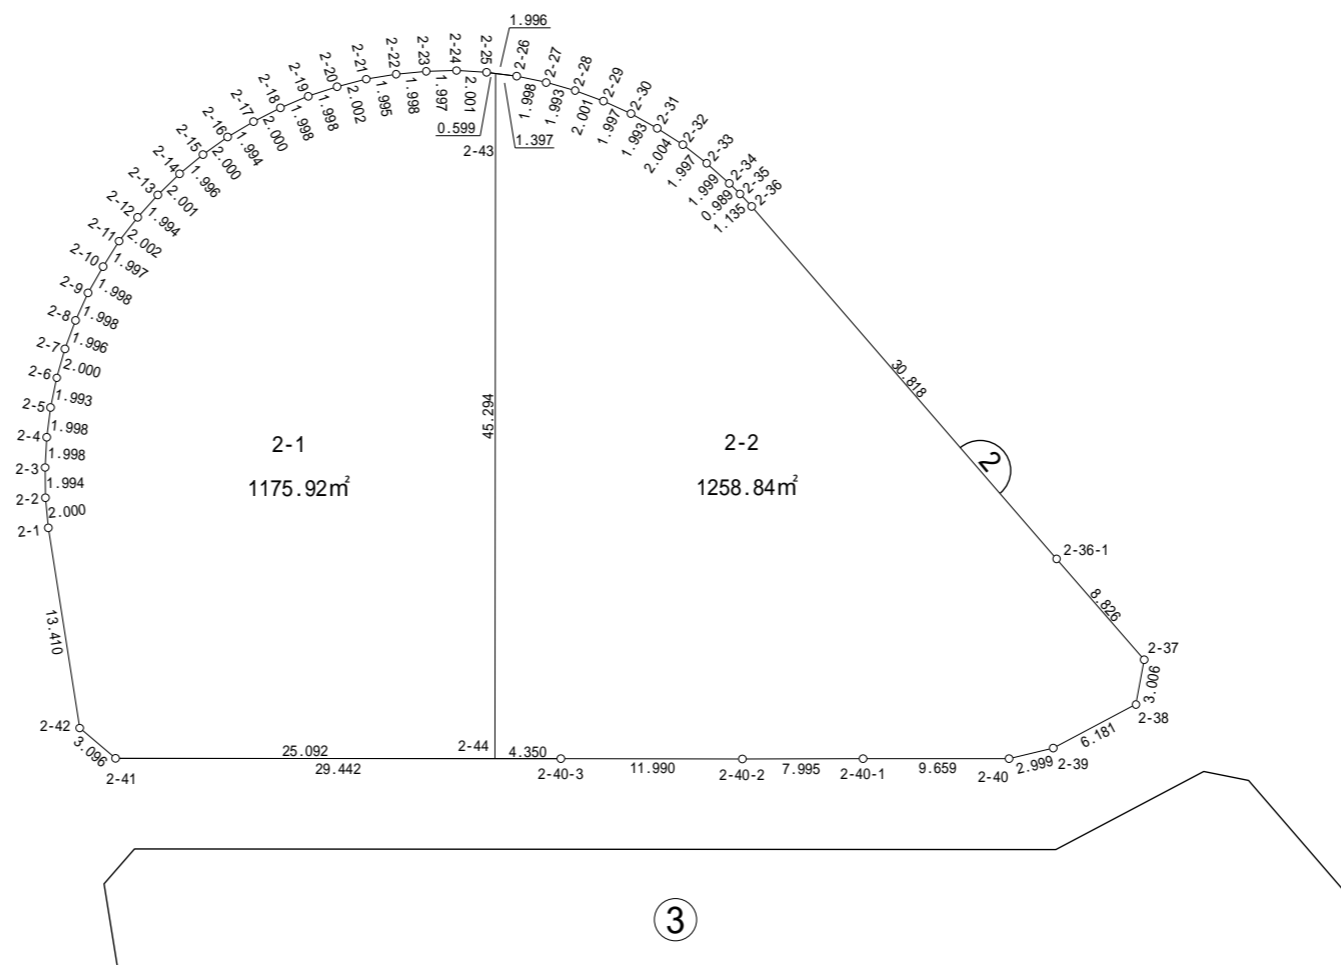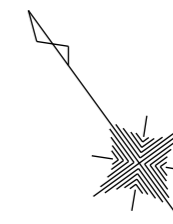

画地出来形図

S = 1 : 500



四街道市
たかおの杜

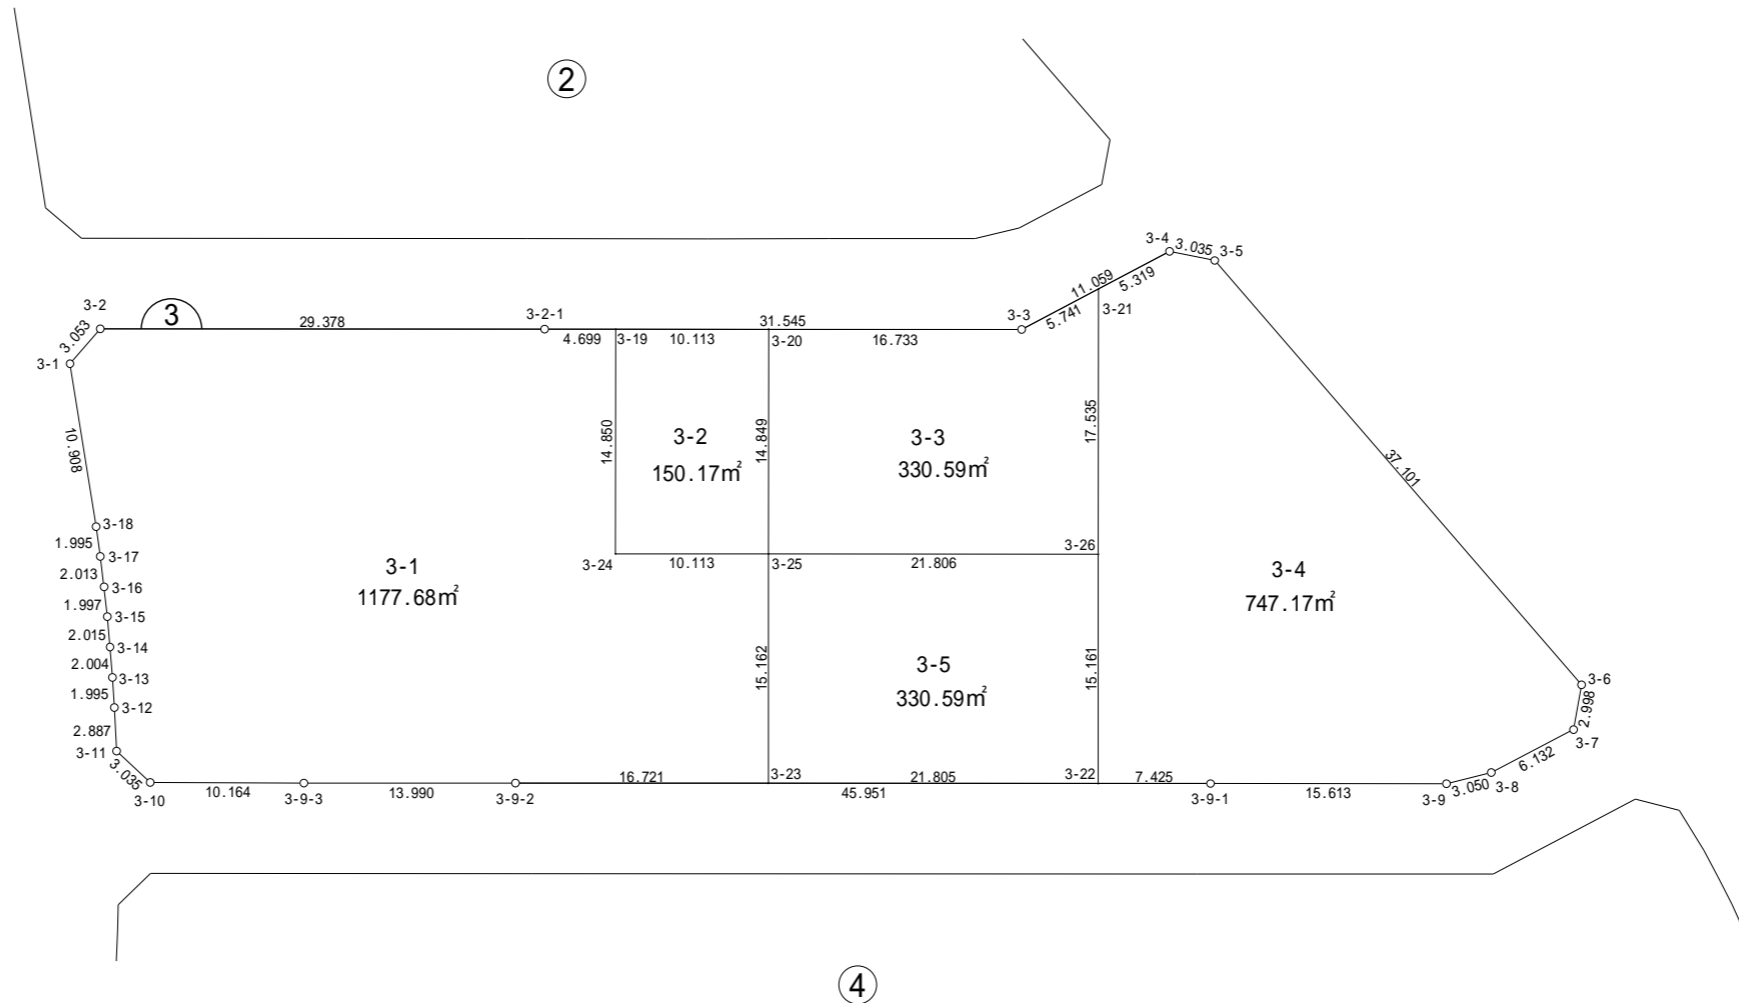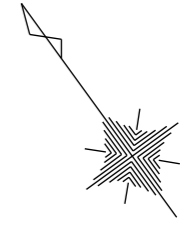

画地出来形図

S = 1 : 5 0 0


四街道市
たかおの杜

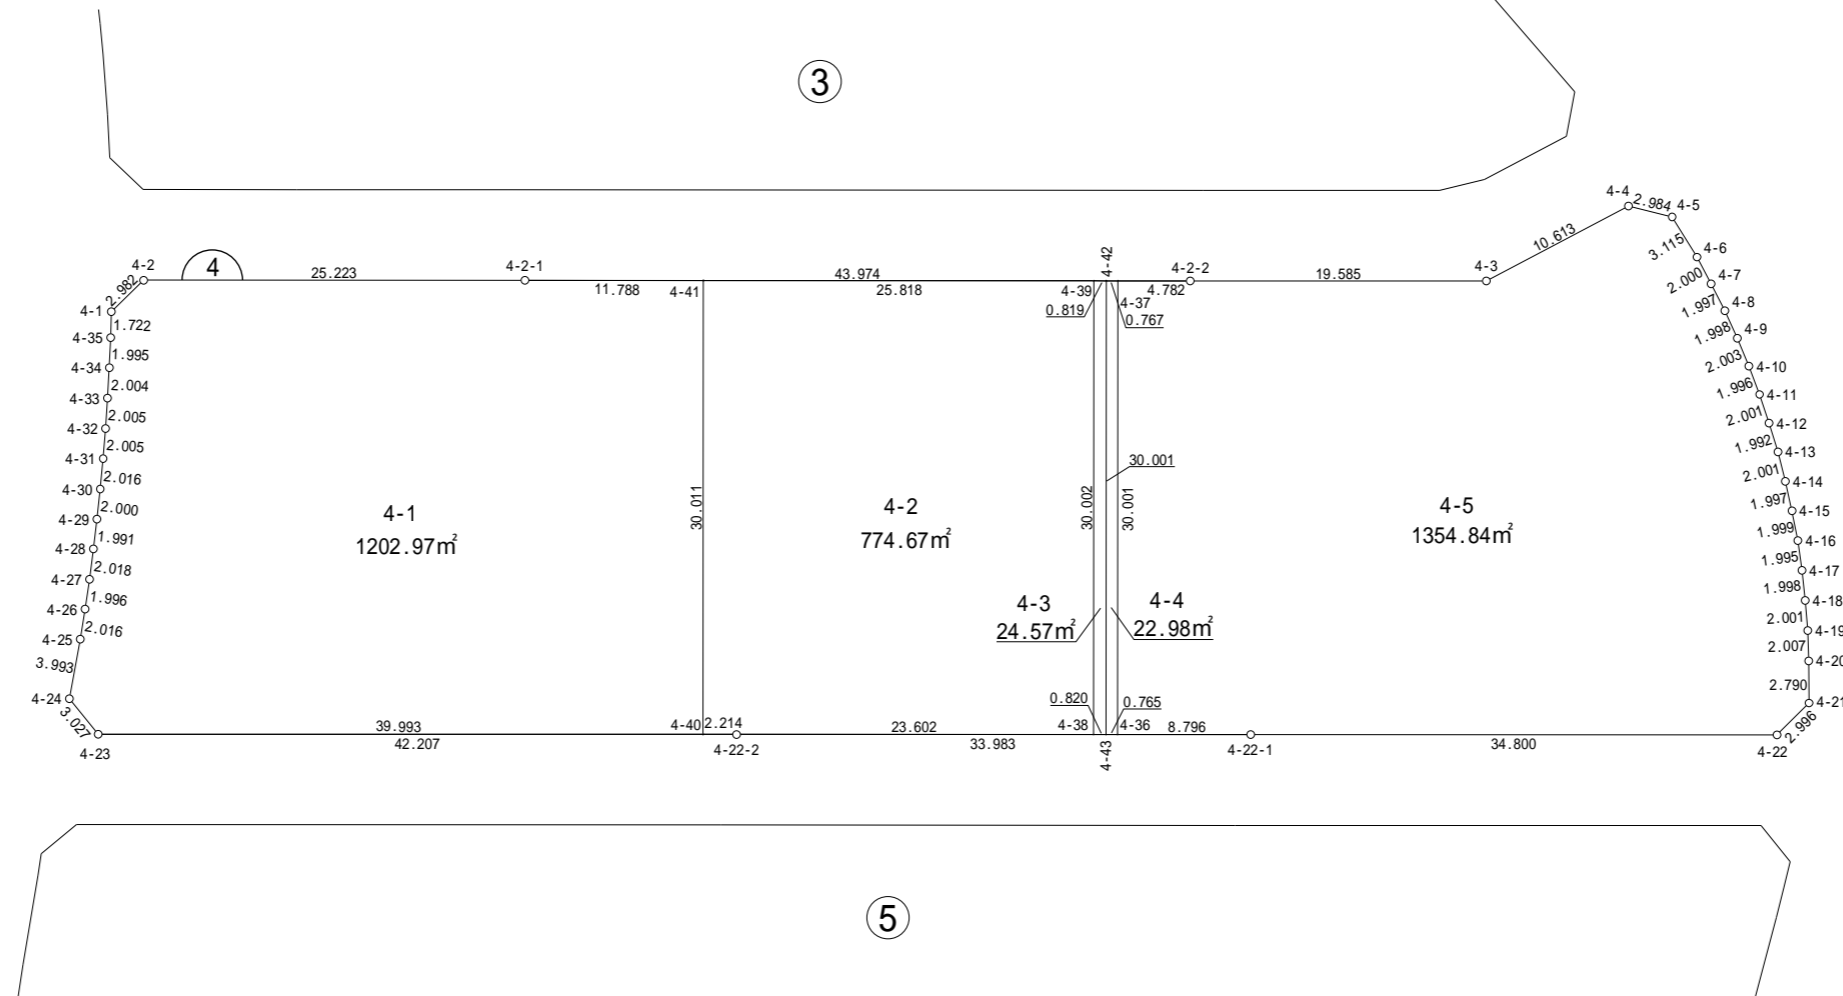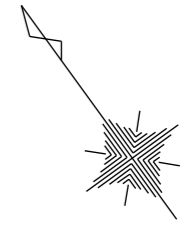


画地出来形図

S = 1 : 5 0 0

四街道市
たかおの杜

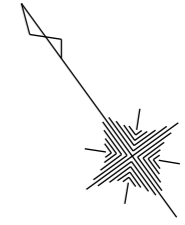

④


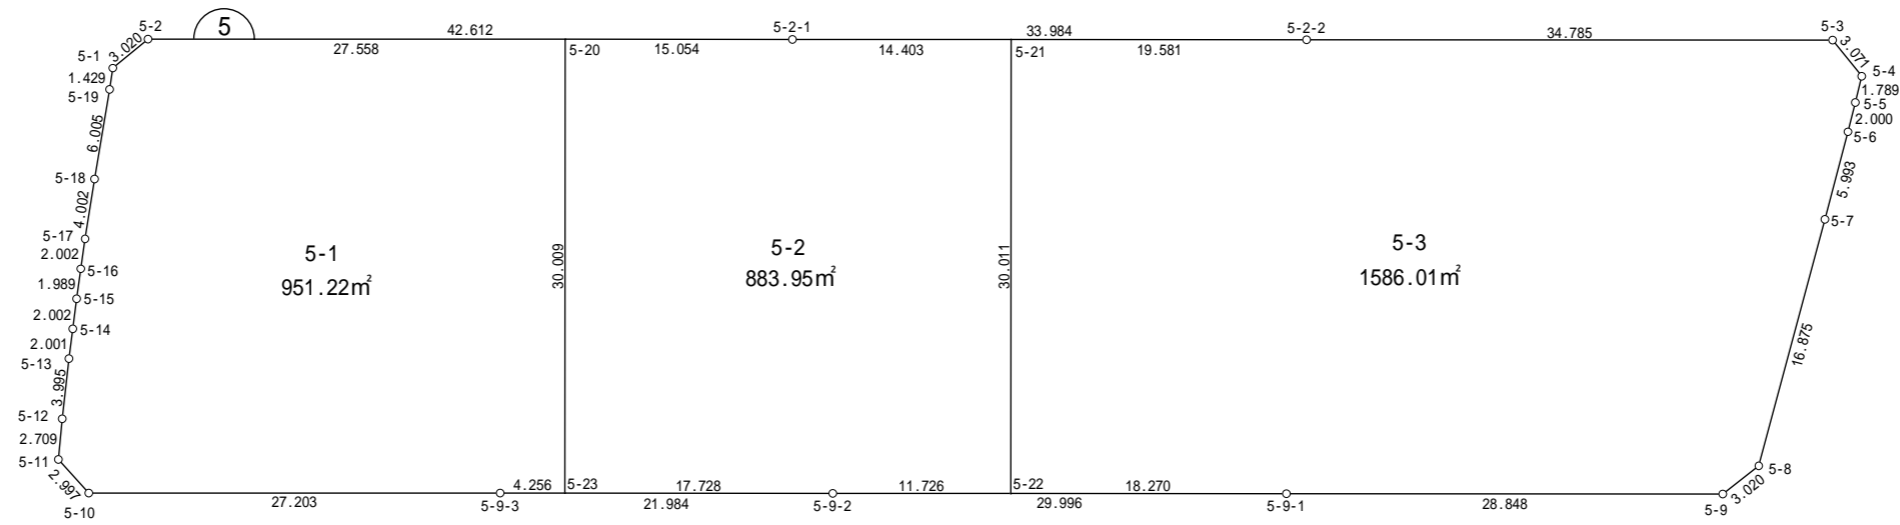


⑥

画地出来形図

S = 1 : 5 0 0



四街道市
たかおの杜

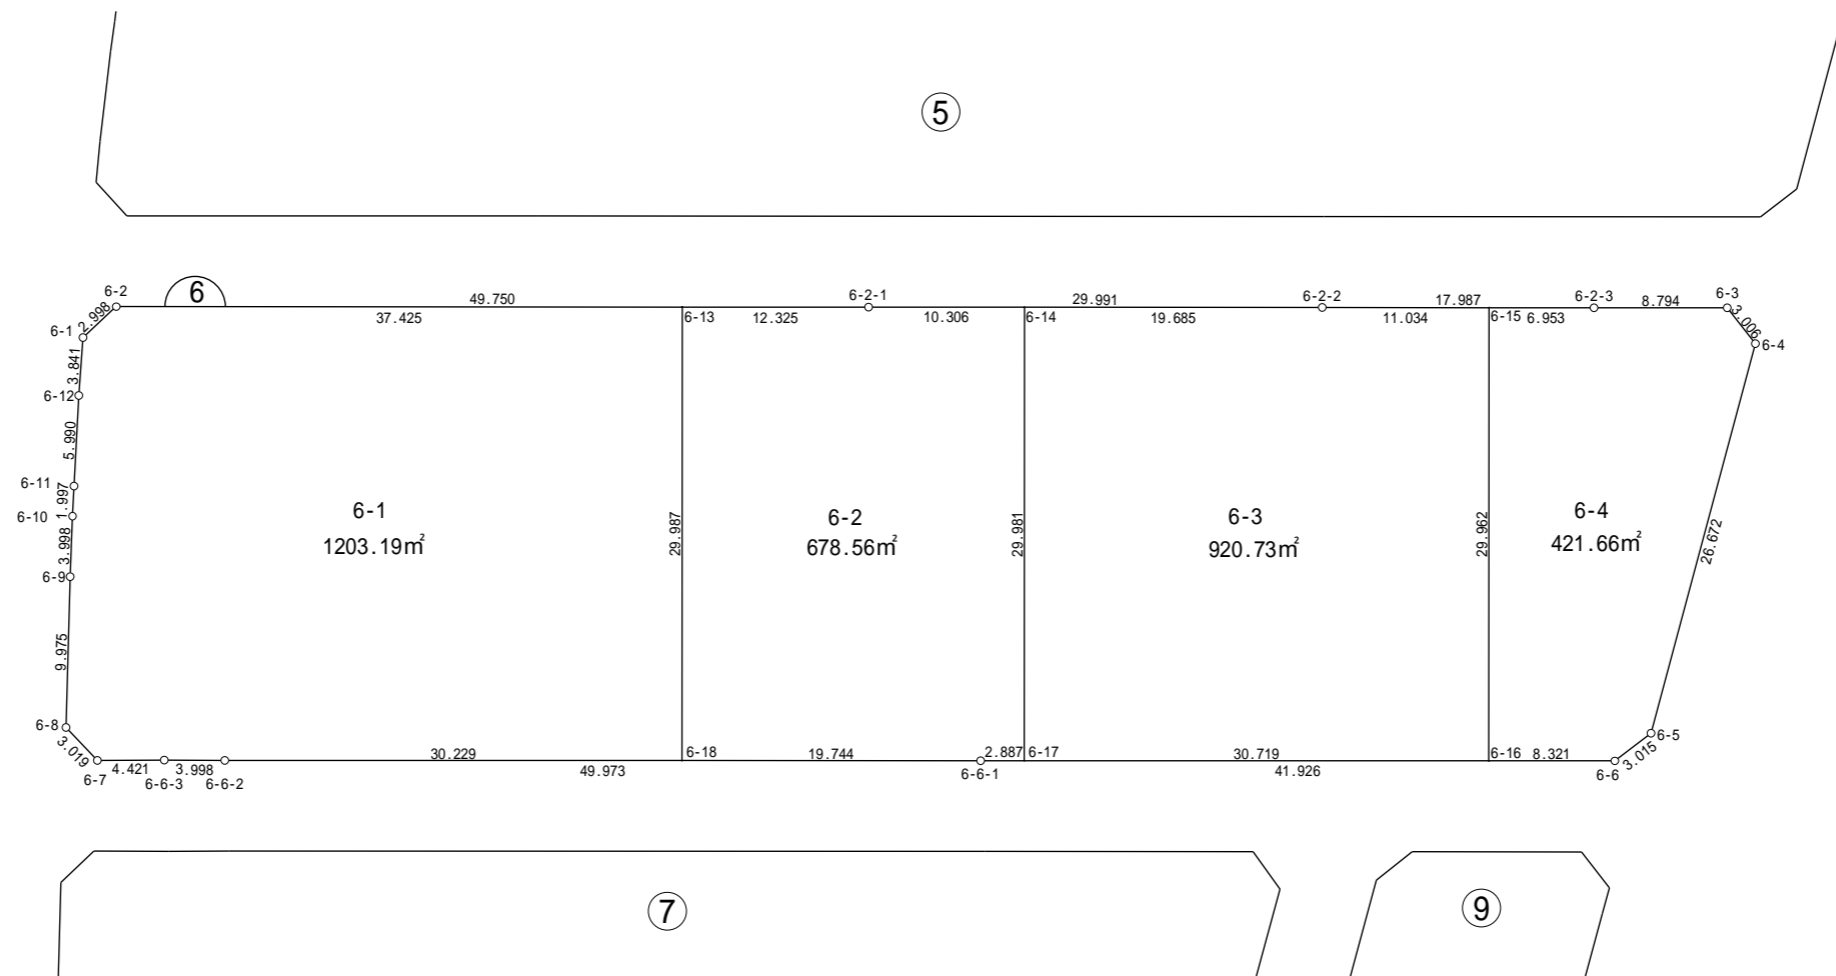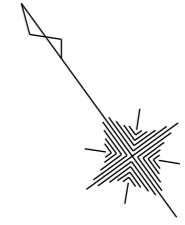

画地出来形図

S = 1 : 500



四街道市
たかおの杜

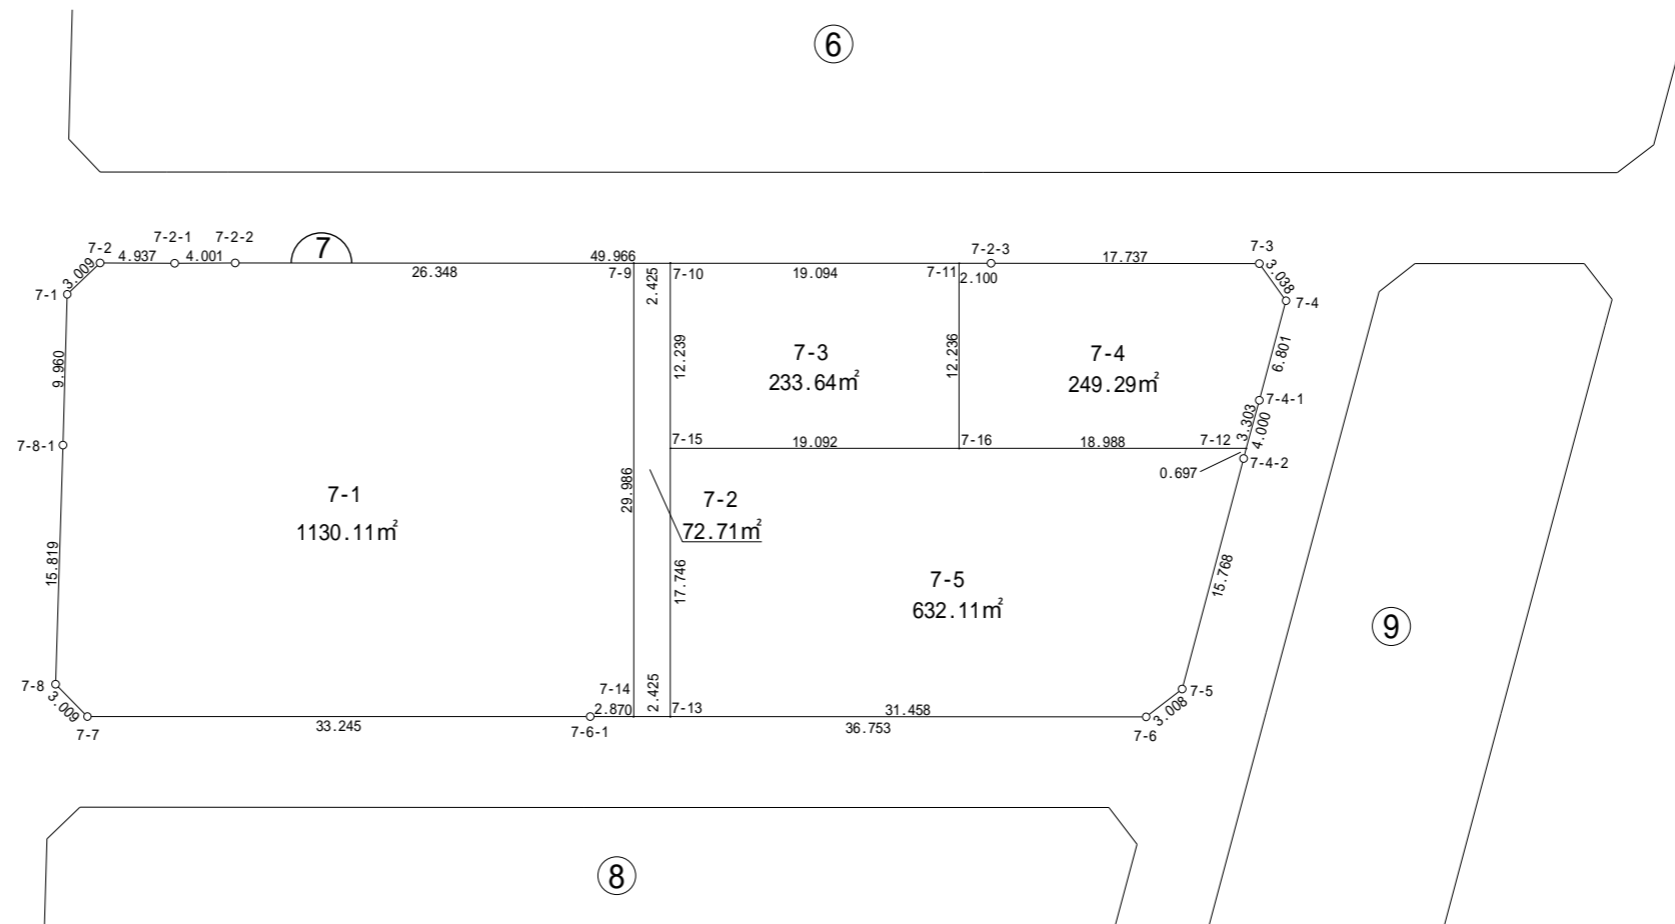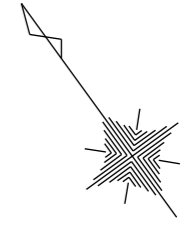

画地出来形図

S = 1 : 500




四街道市
たかおの杜

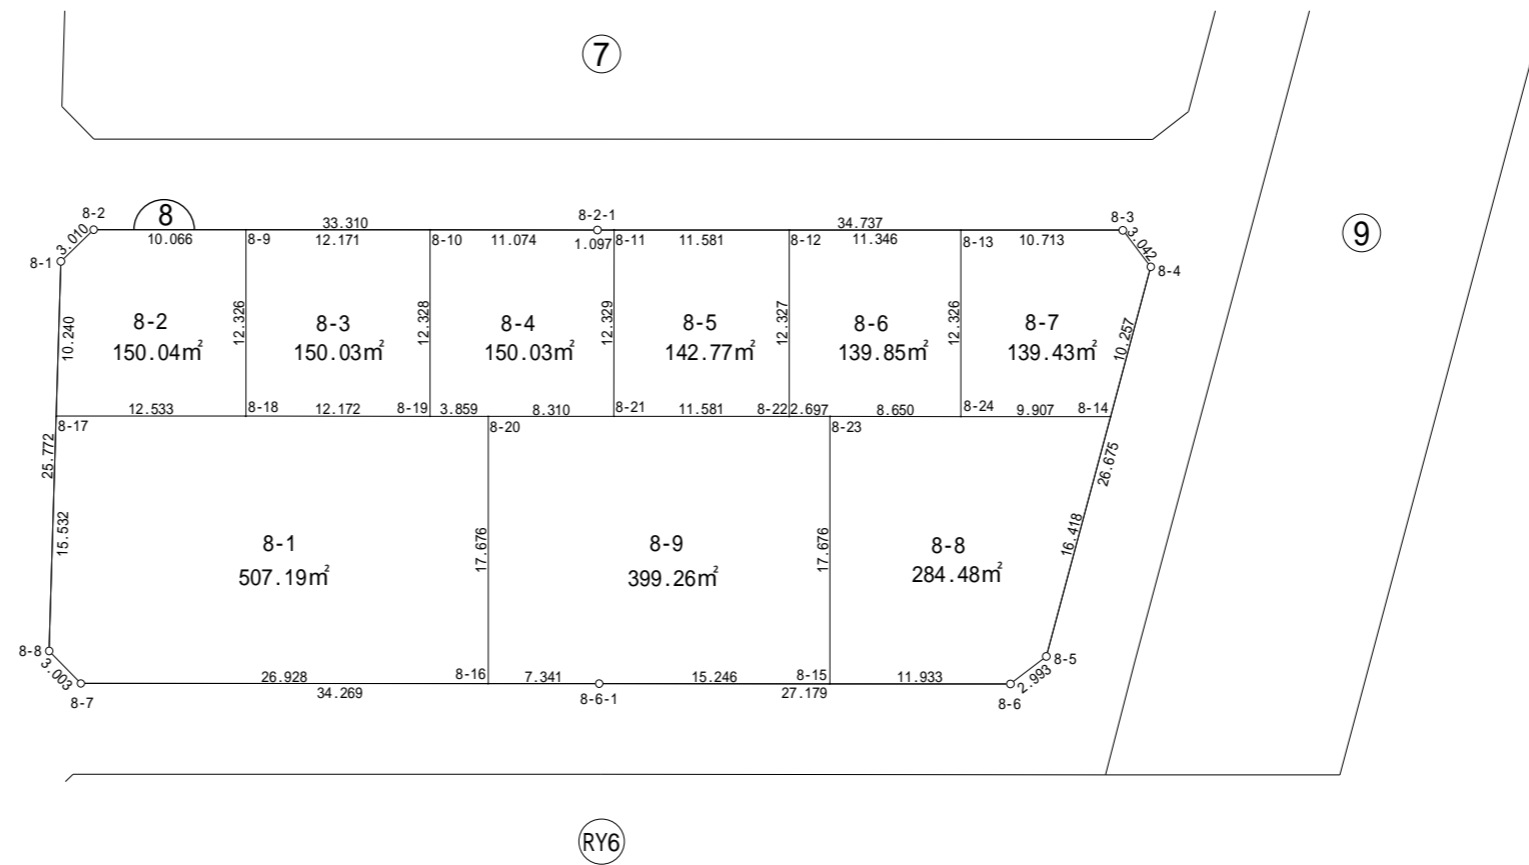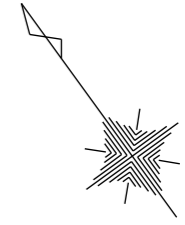

画地出来形図

S = 1 : 500

四街道市
たかおの杜

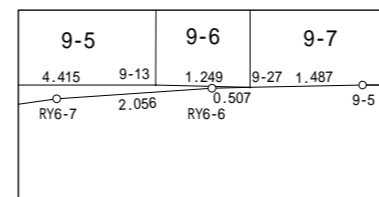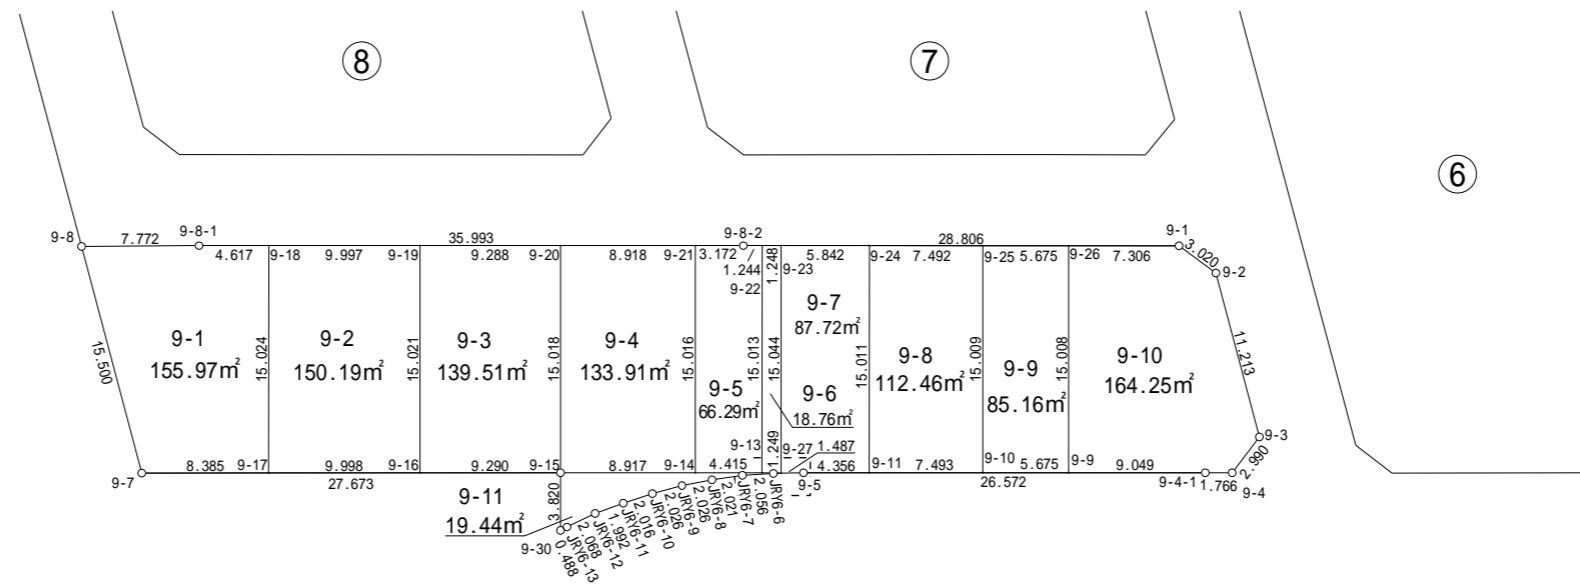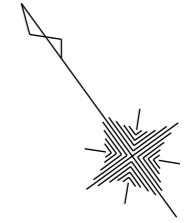


拡大図 1/100

画地出来形図


S = 1 : 1500

四街道市
たかおの杜


拡大図 1/250

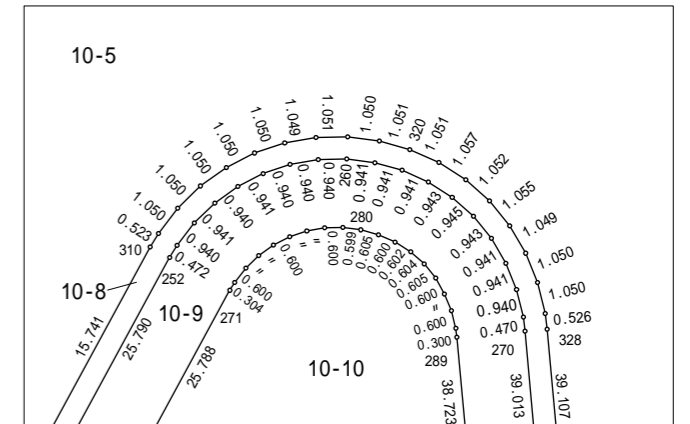

拡大図 1/250

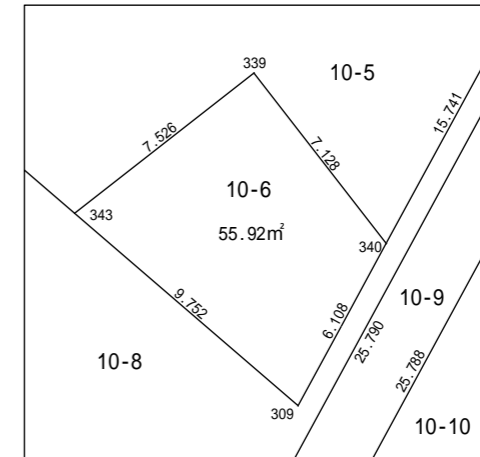

拡大図 1/200

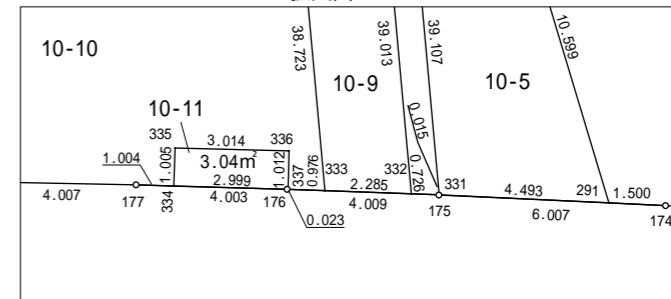

10-3
61829.63㎡

10-2
113.34㎡

10-1
11033.80㎡

10-4
3350.31㎡

10-8
1187.52㎡

10-5
2537.46㎡


10-10
5035.80㎡

10-9
182.17㎡

10-7
1428.52㎡





拡大図 1/150

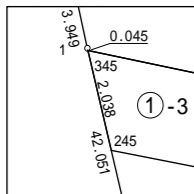

画地出来形図

S = 1 : 250



四街道市
たかおの杜

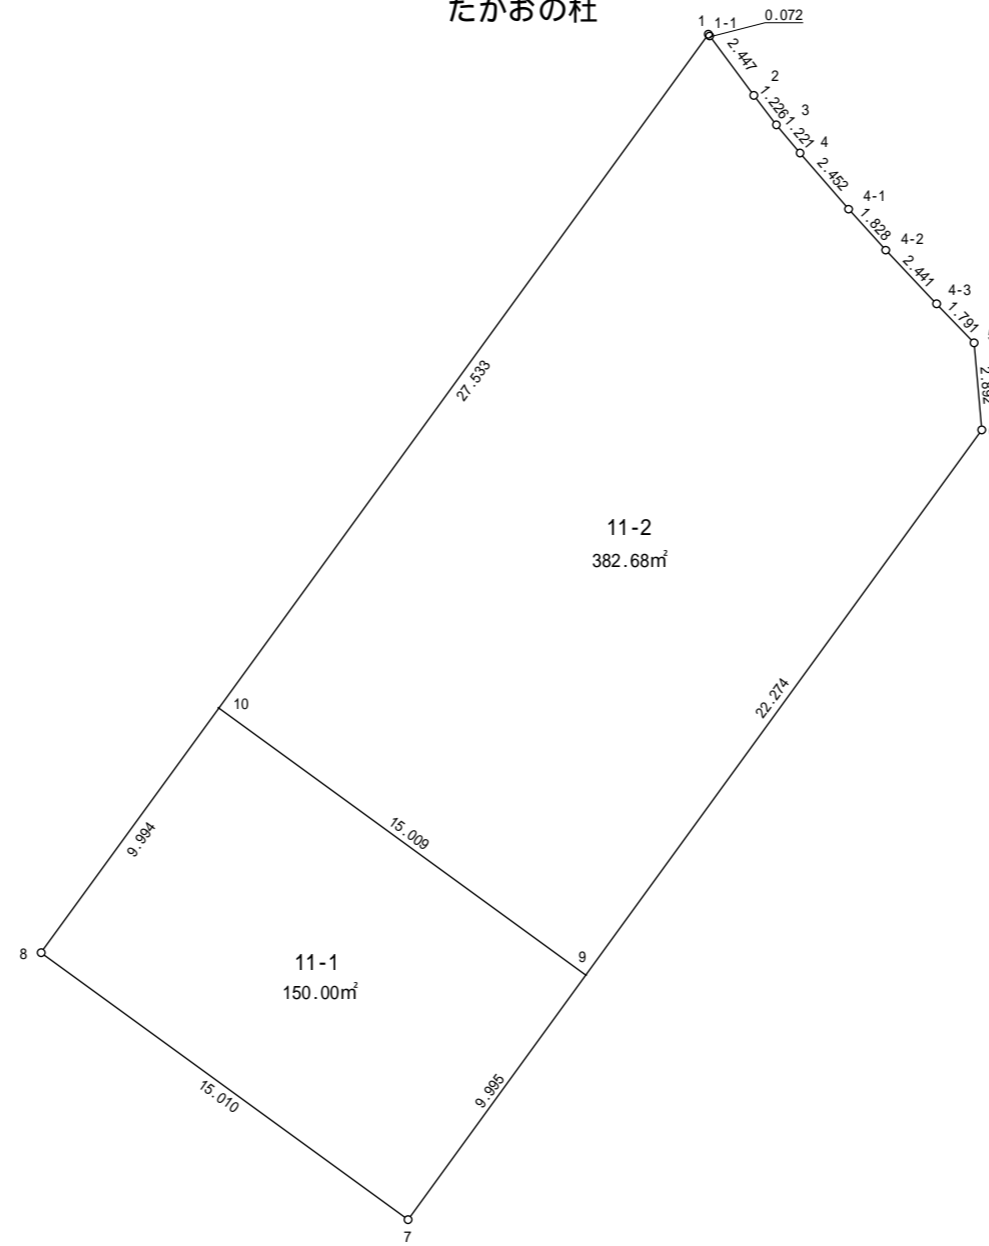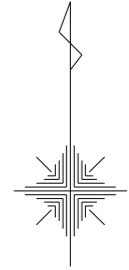

画地出来形図

S = 1 : 5 0 0



四街道市
たかおの杜

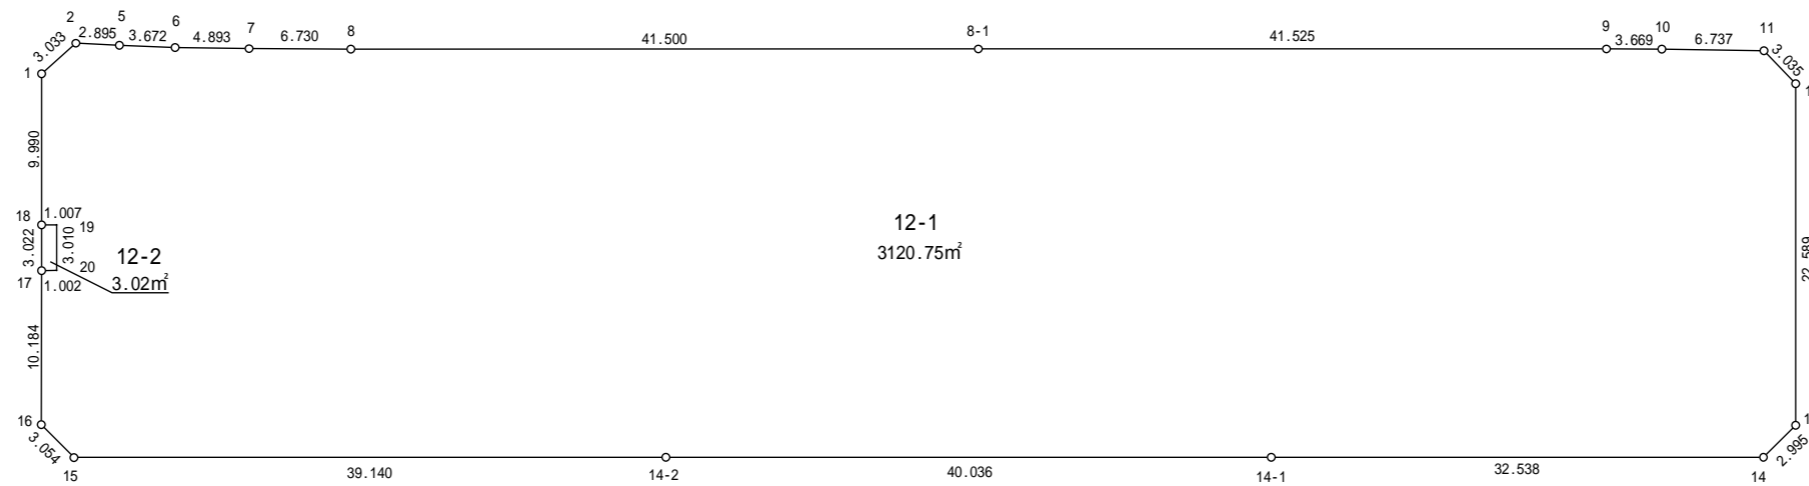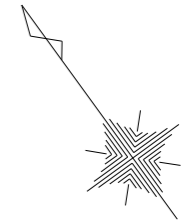

画地出来形図


S = 1 : 500

四街道市
たかおの杜

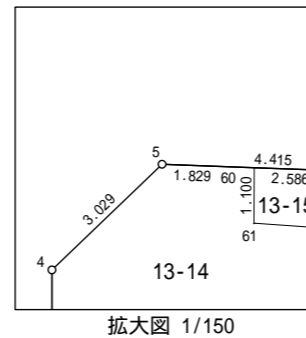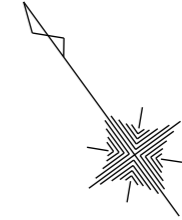

拡大図 1/150

12

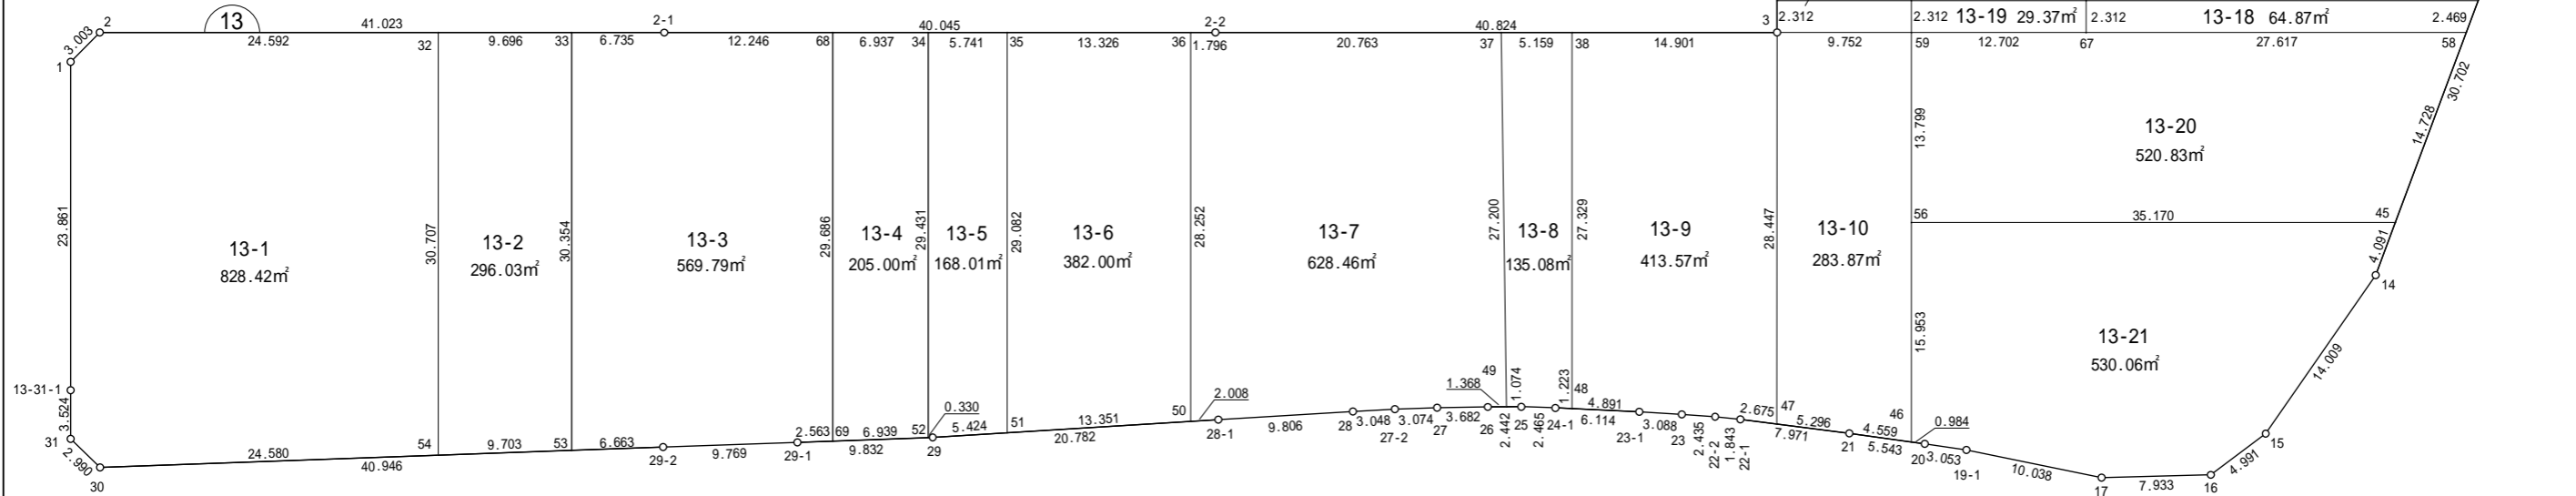


13

画地出来形図

S = 1 : 500

四街道市
たかおの杜


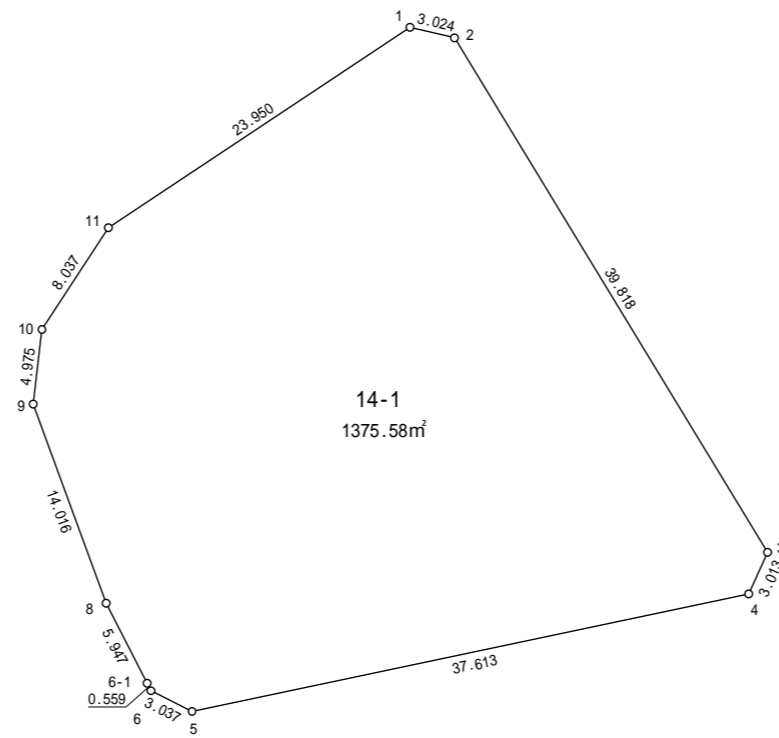


画地出来形図

S = 1 : 250

四街道市



たかおの杜

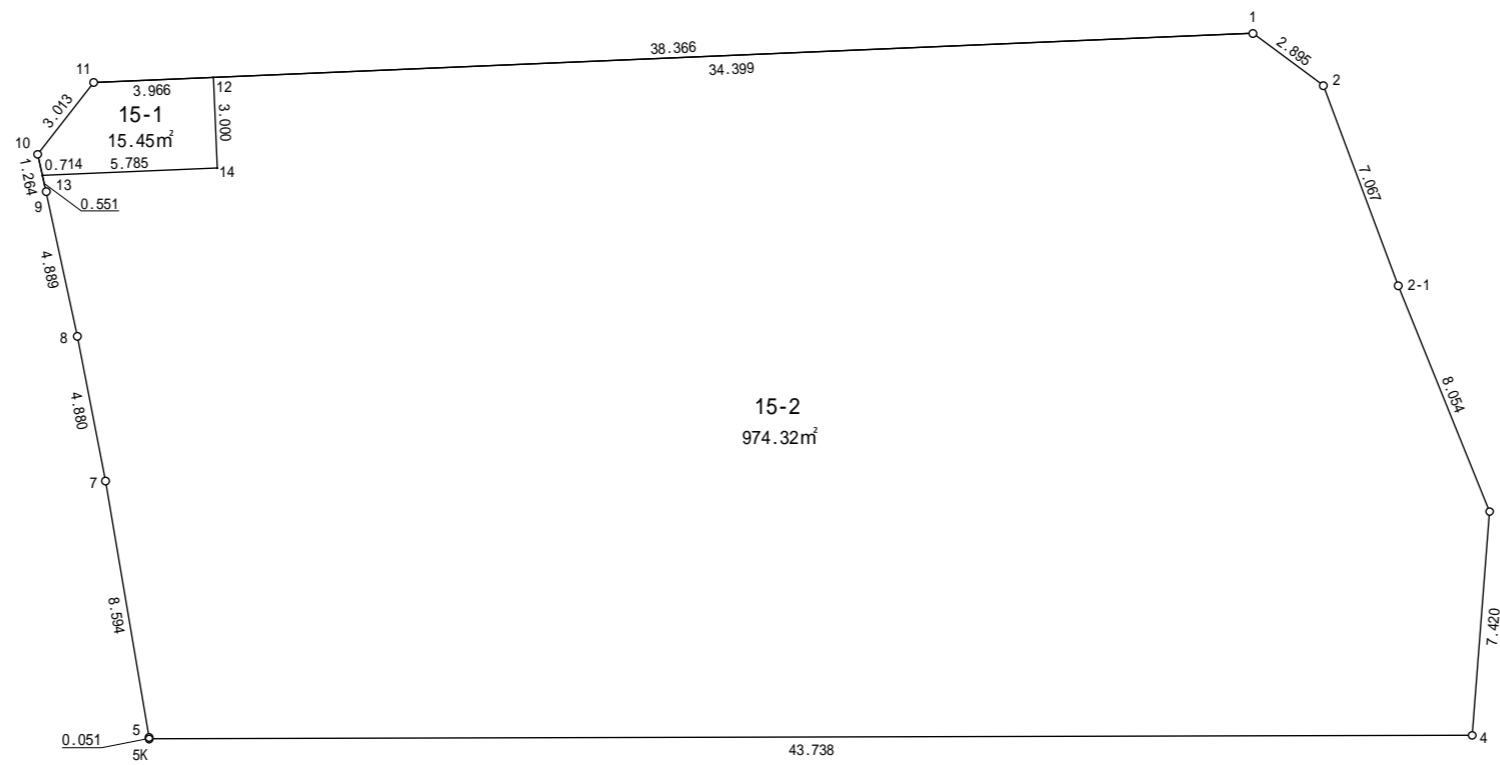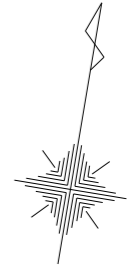

画地出来形図

S = 1 : 1 0 0 0



四街道市
たかおの杜

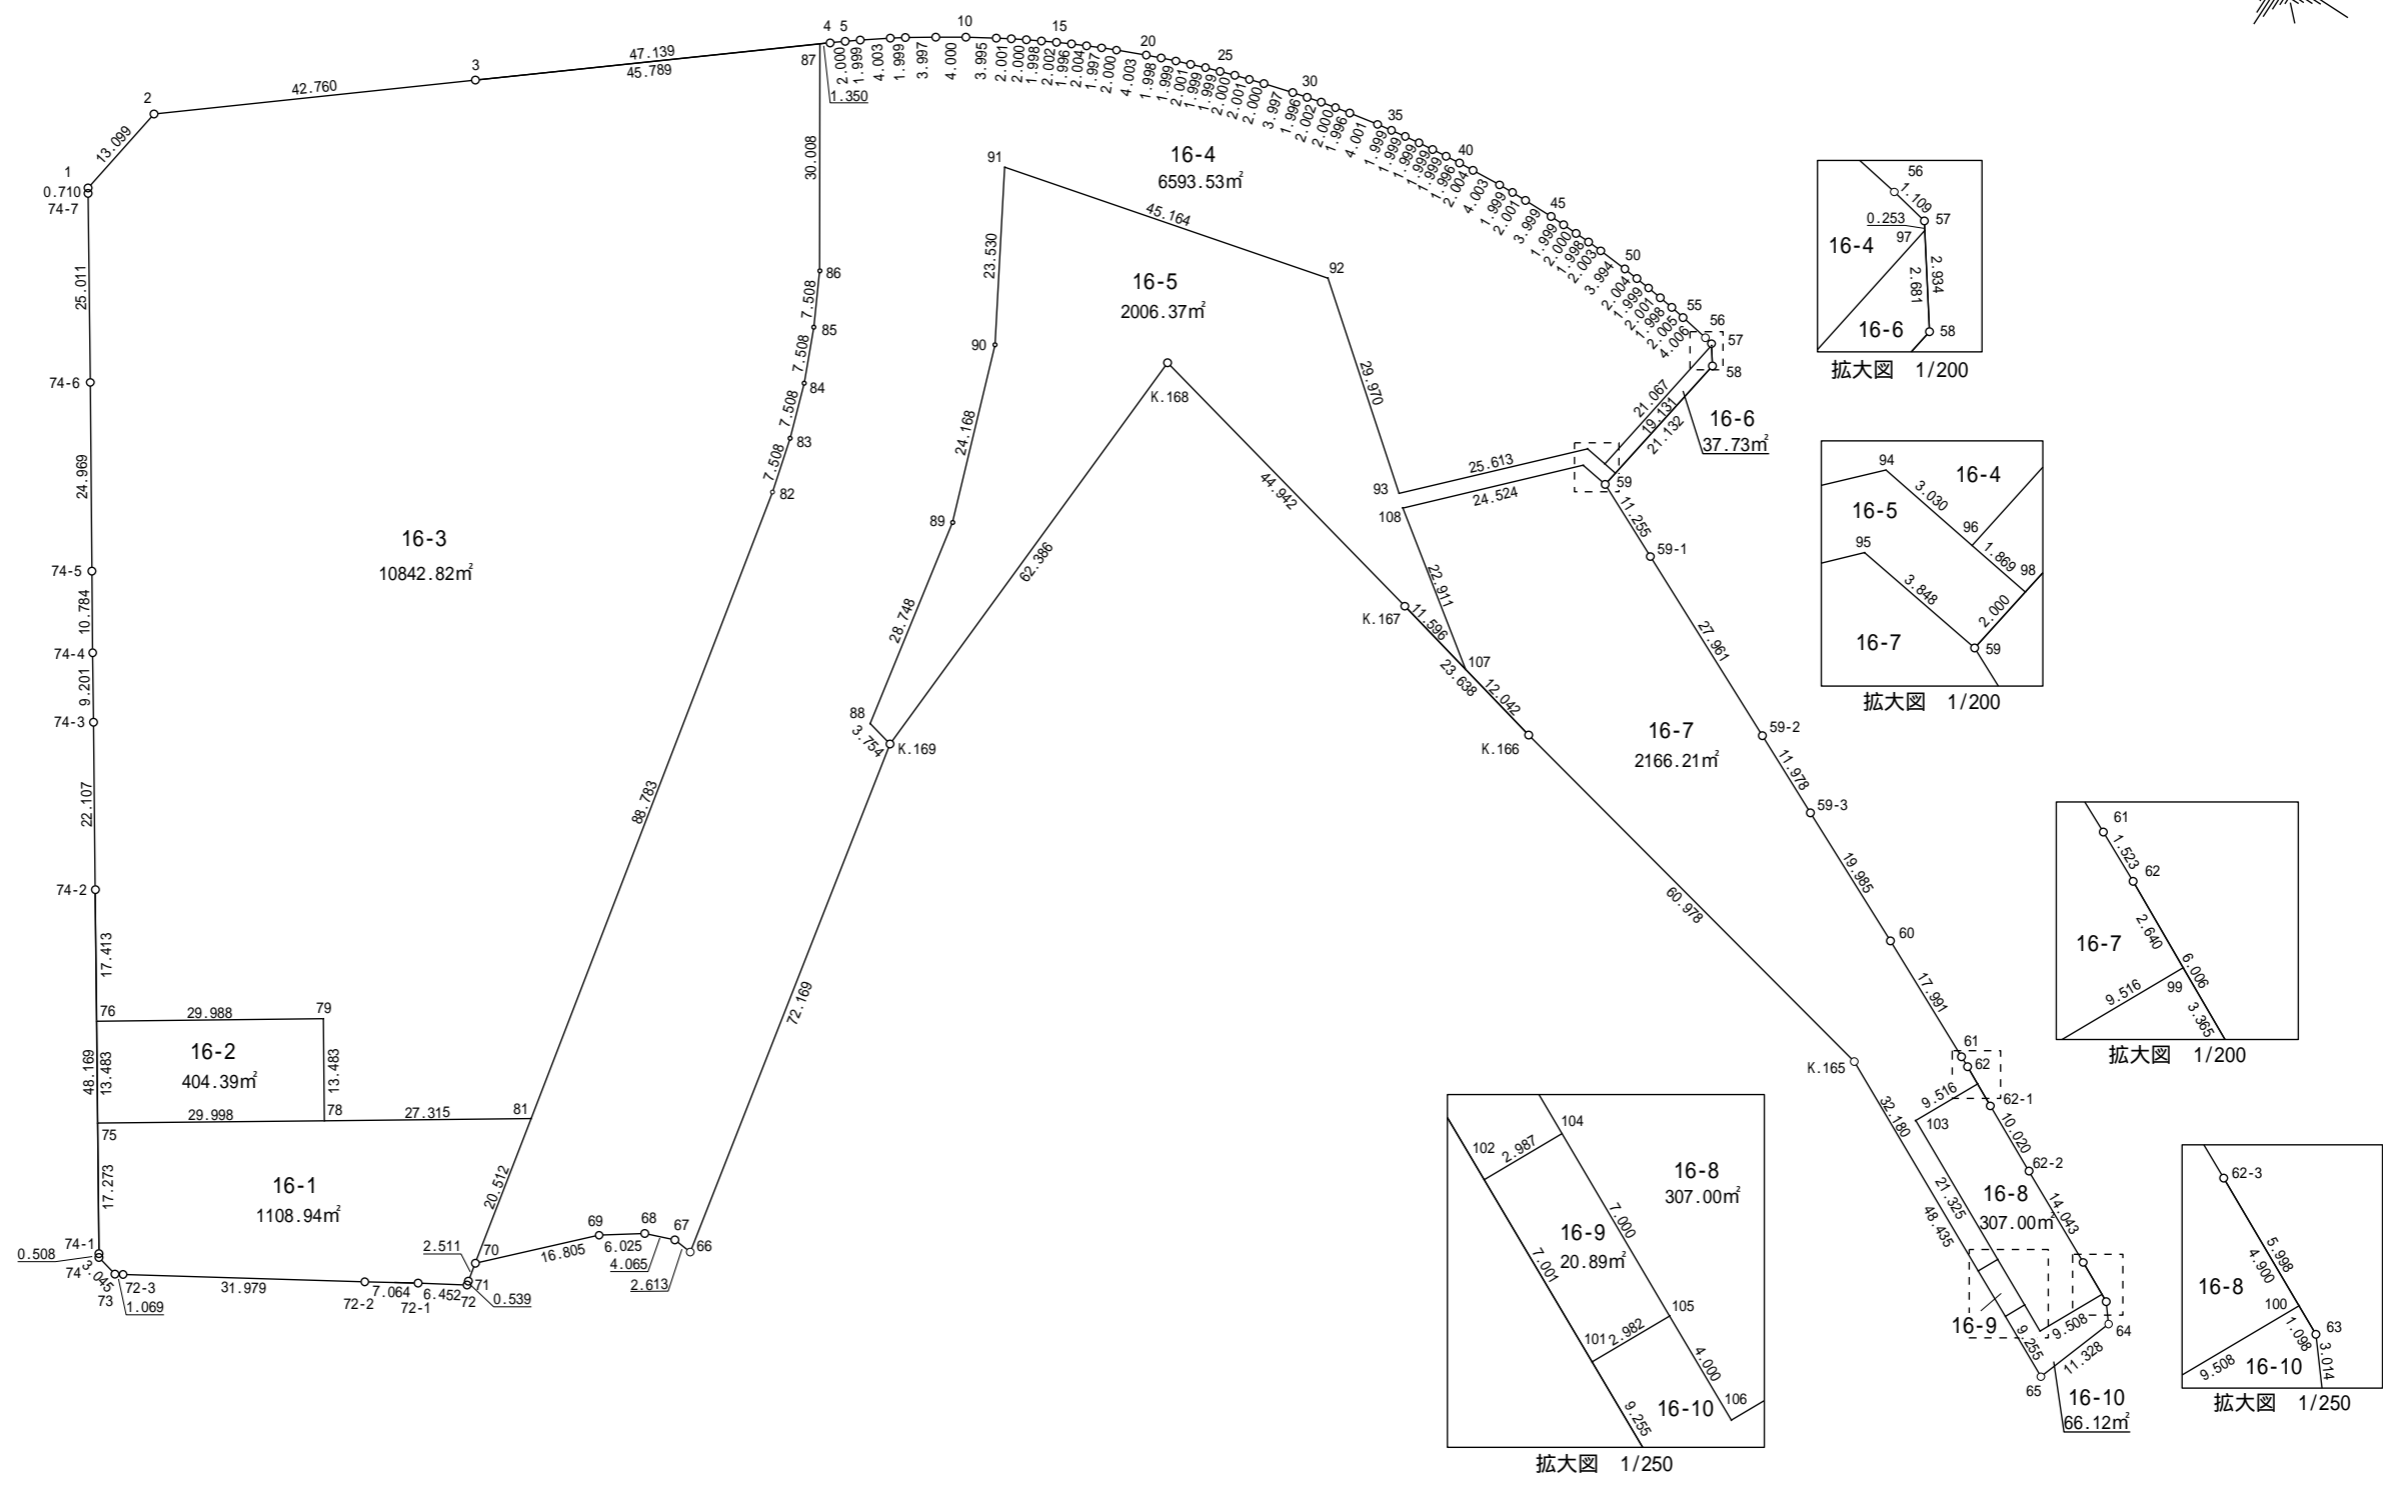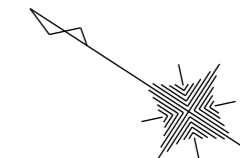

画地出来形図

S = 1 : 500



四街道市
たかおの杜

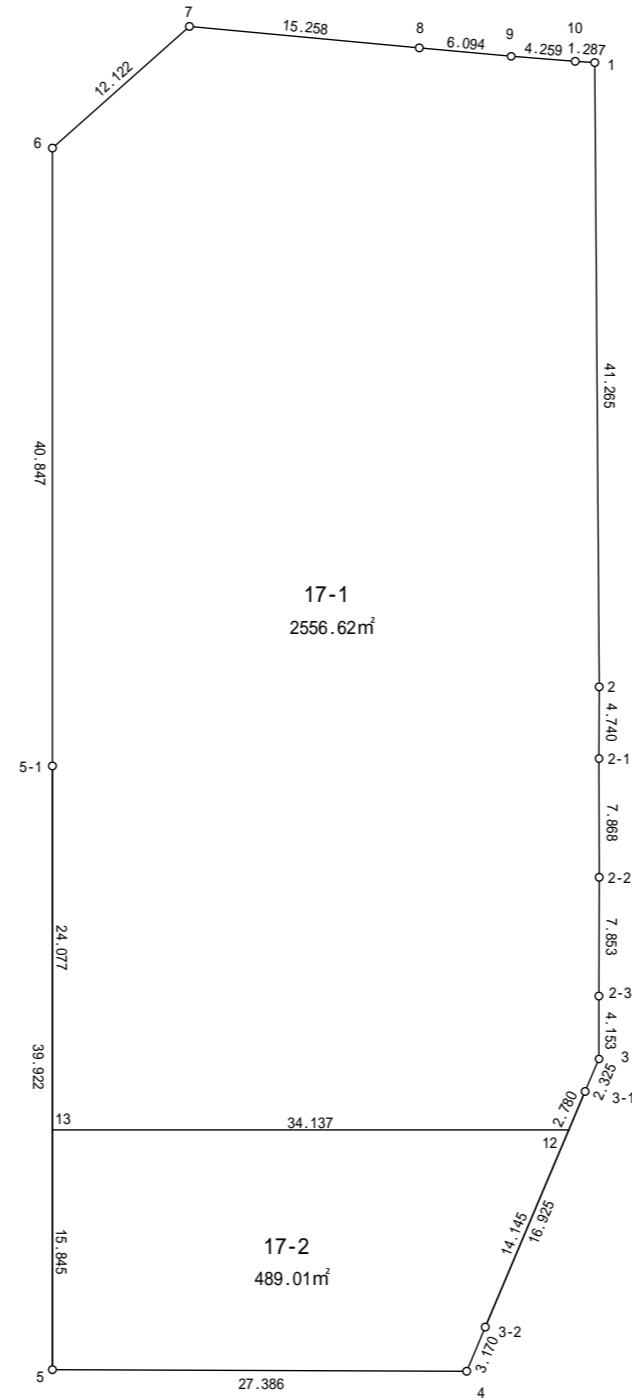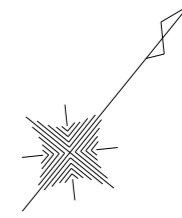

画地出来形図

S = 1 : 3 0 0



四街道市
たかおの杜

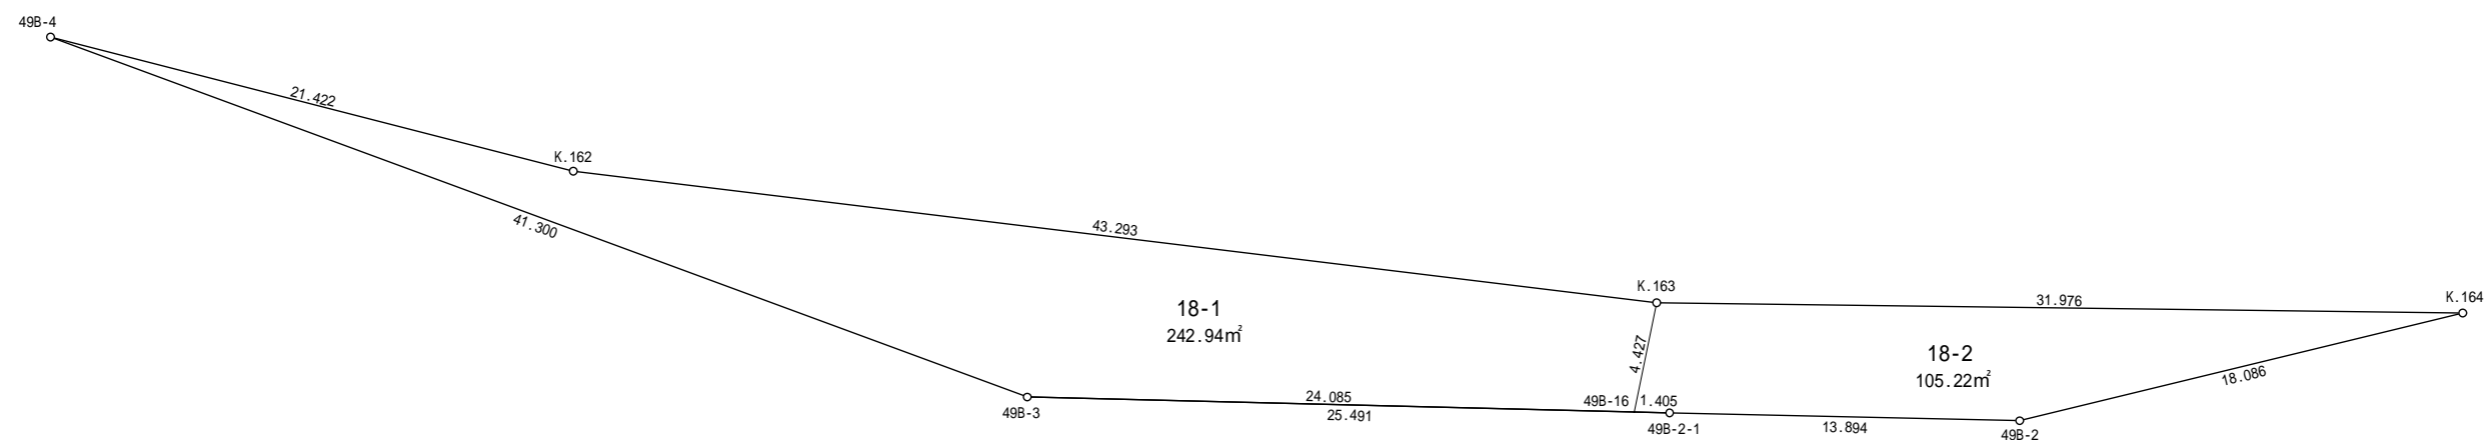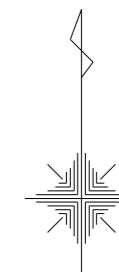

画地出来形図

S = 1 : 100




四街道市
たかおの杜

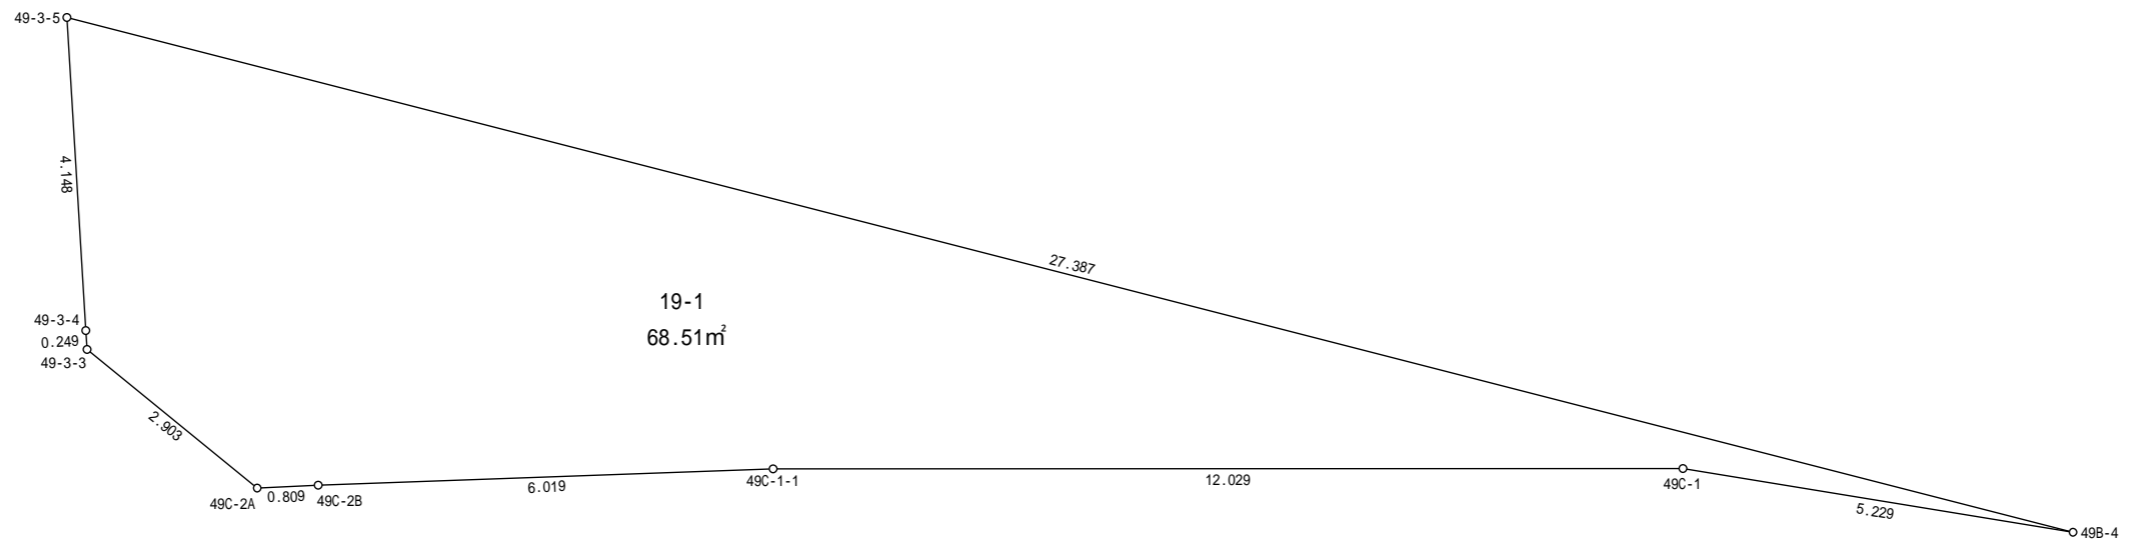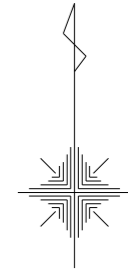


画地出来形図

S = 1 : 1000

四街道市
たかおの杜

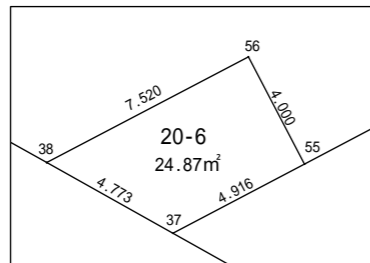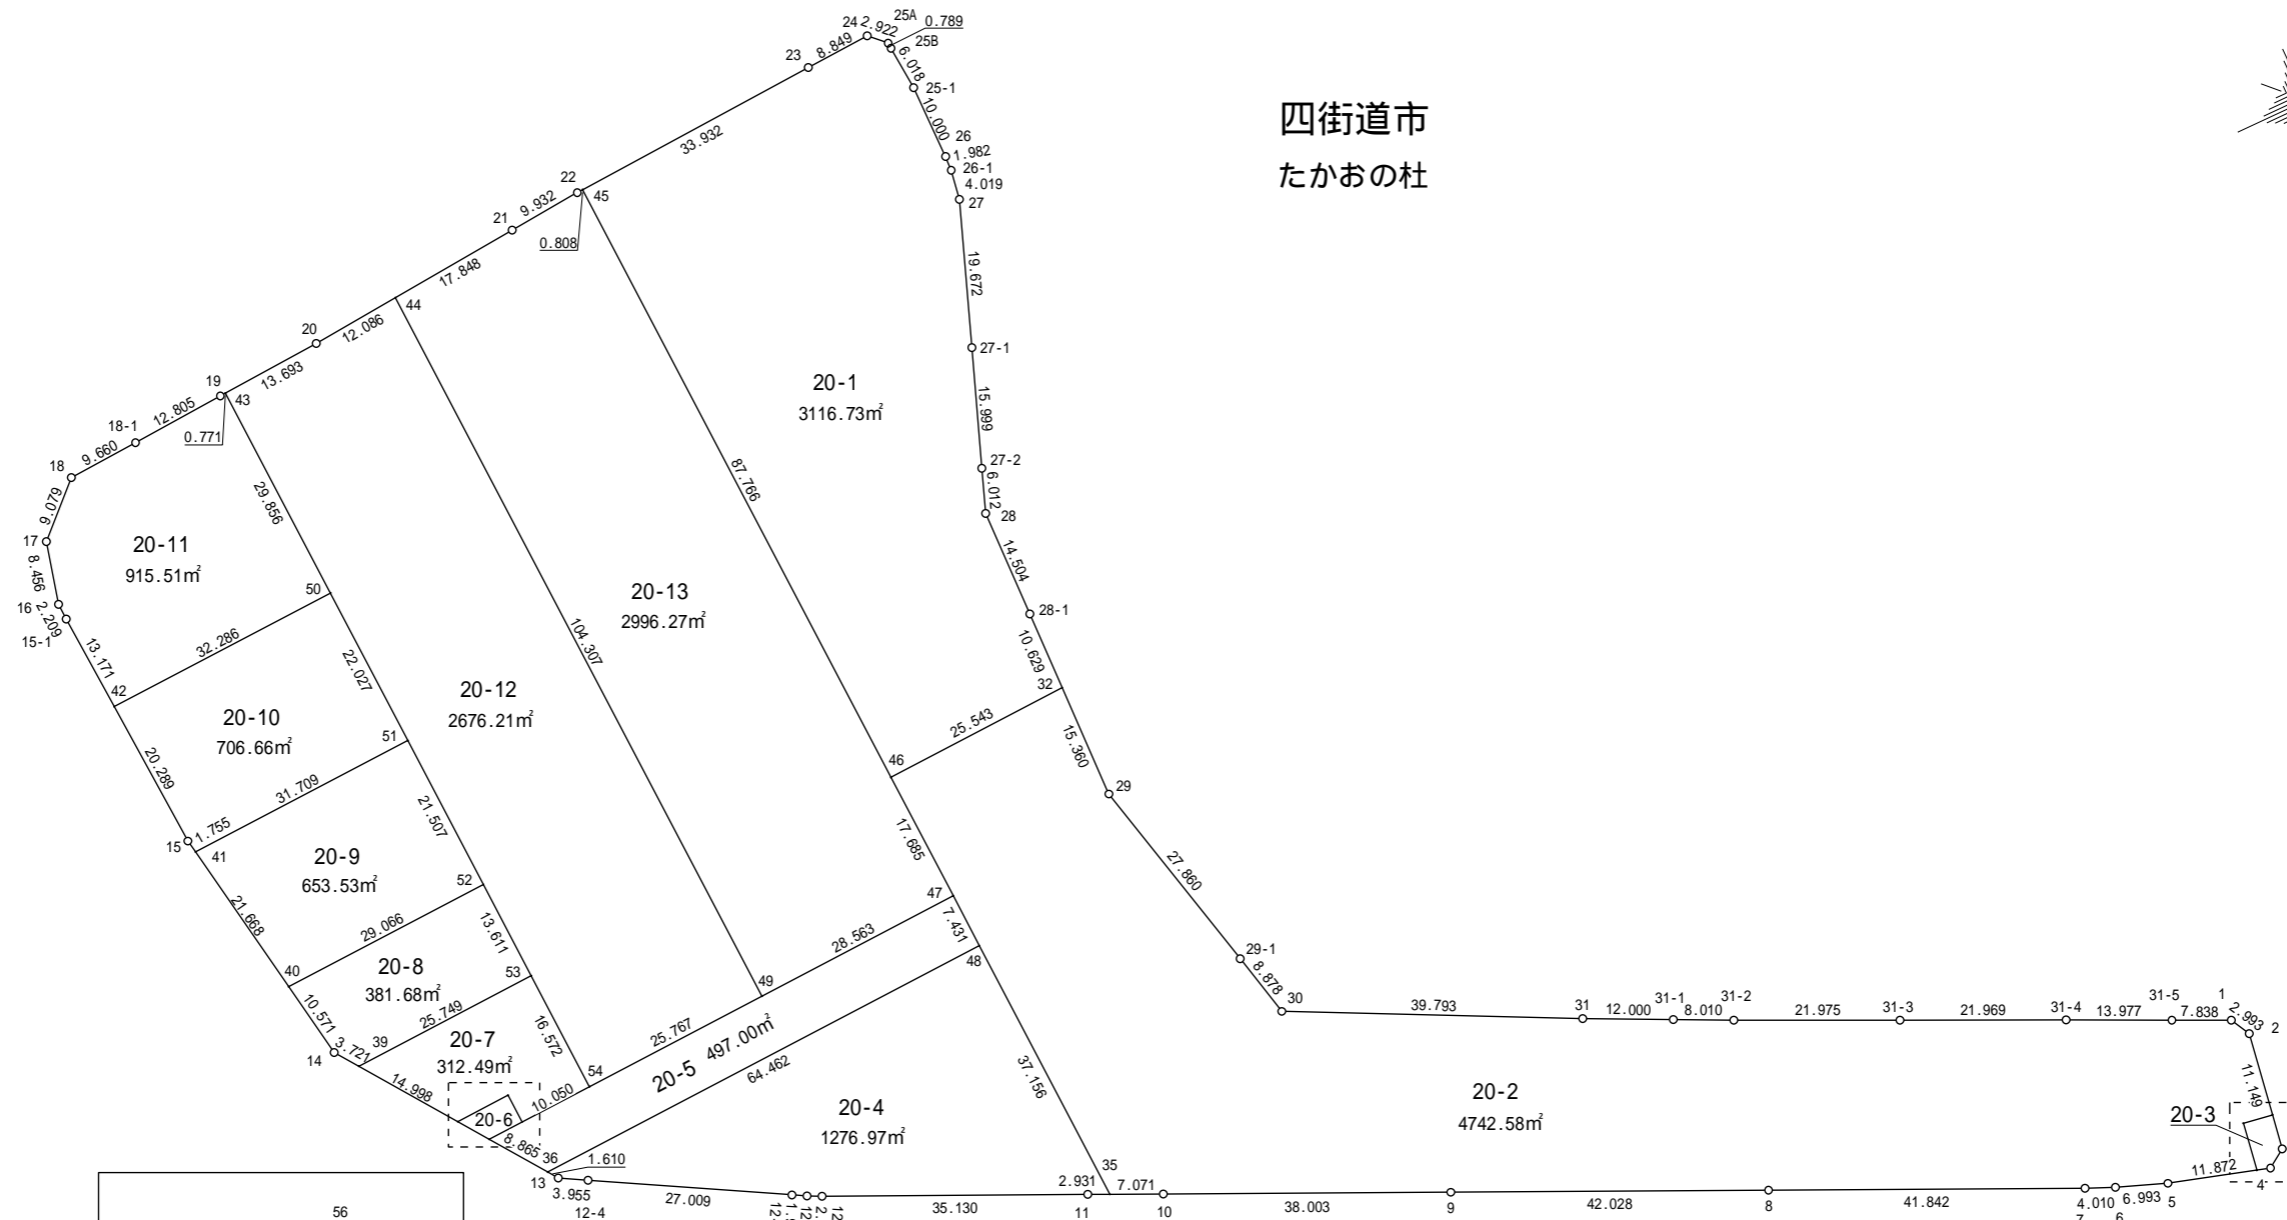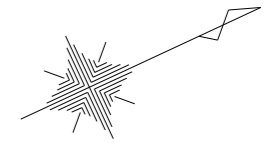

拡大図 1/250

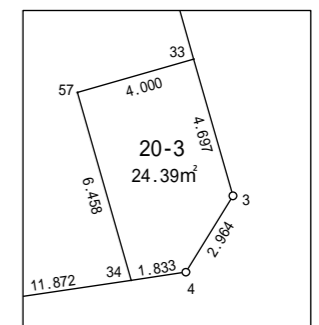

拡大図 1/250

画地出来形図

S = 1 : 1500

四街道市
たかおの杜



21-3
61306.21m²

21-4
65158.43m²

21-1
13217.43m²

21-2
29795.62m²




拡大図 1/1000

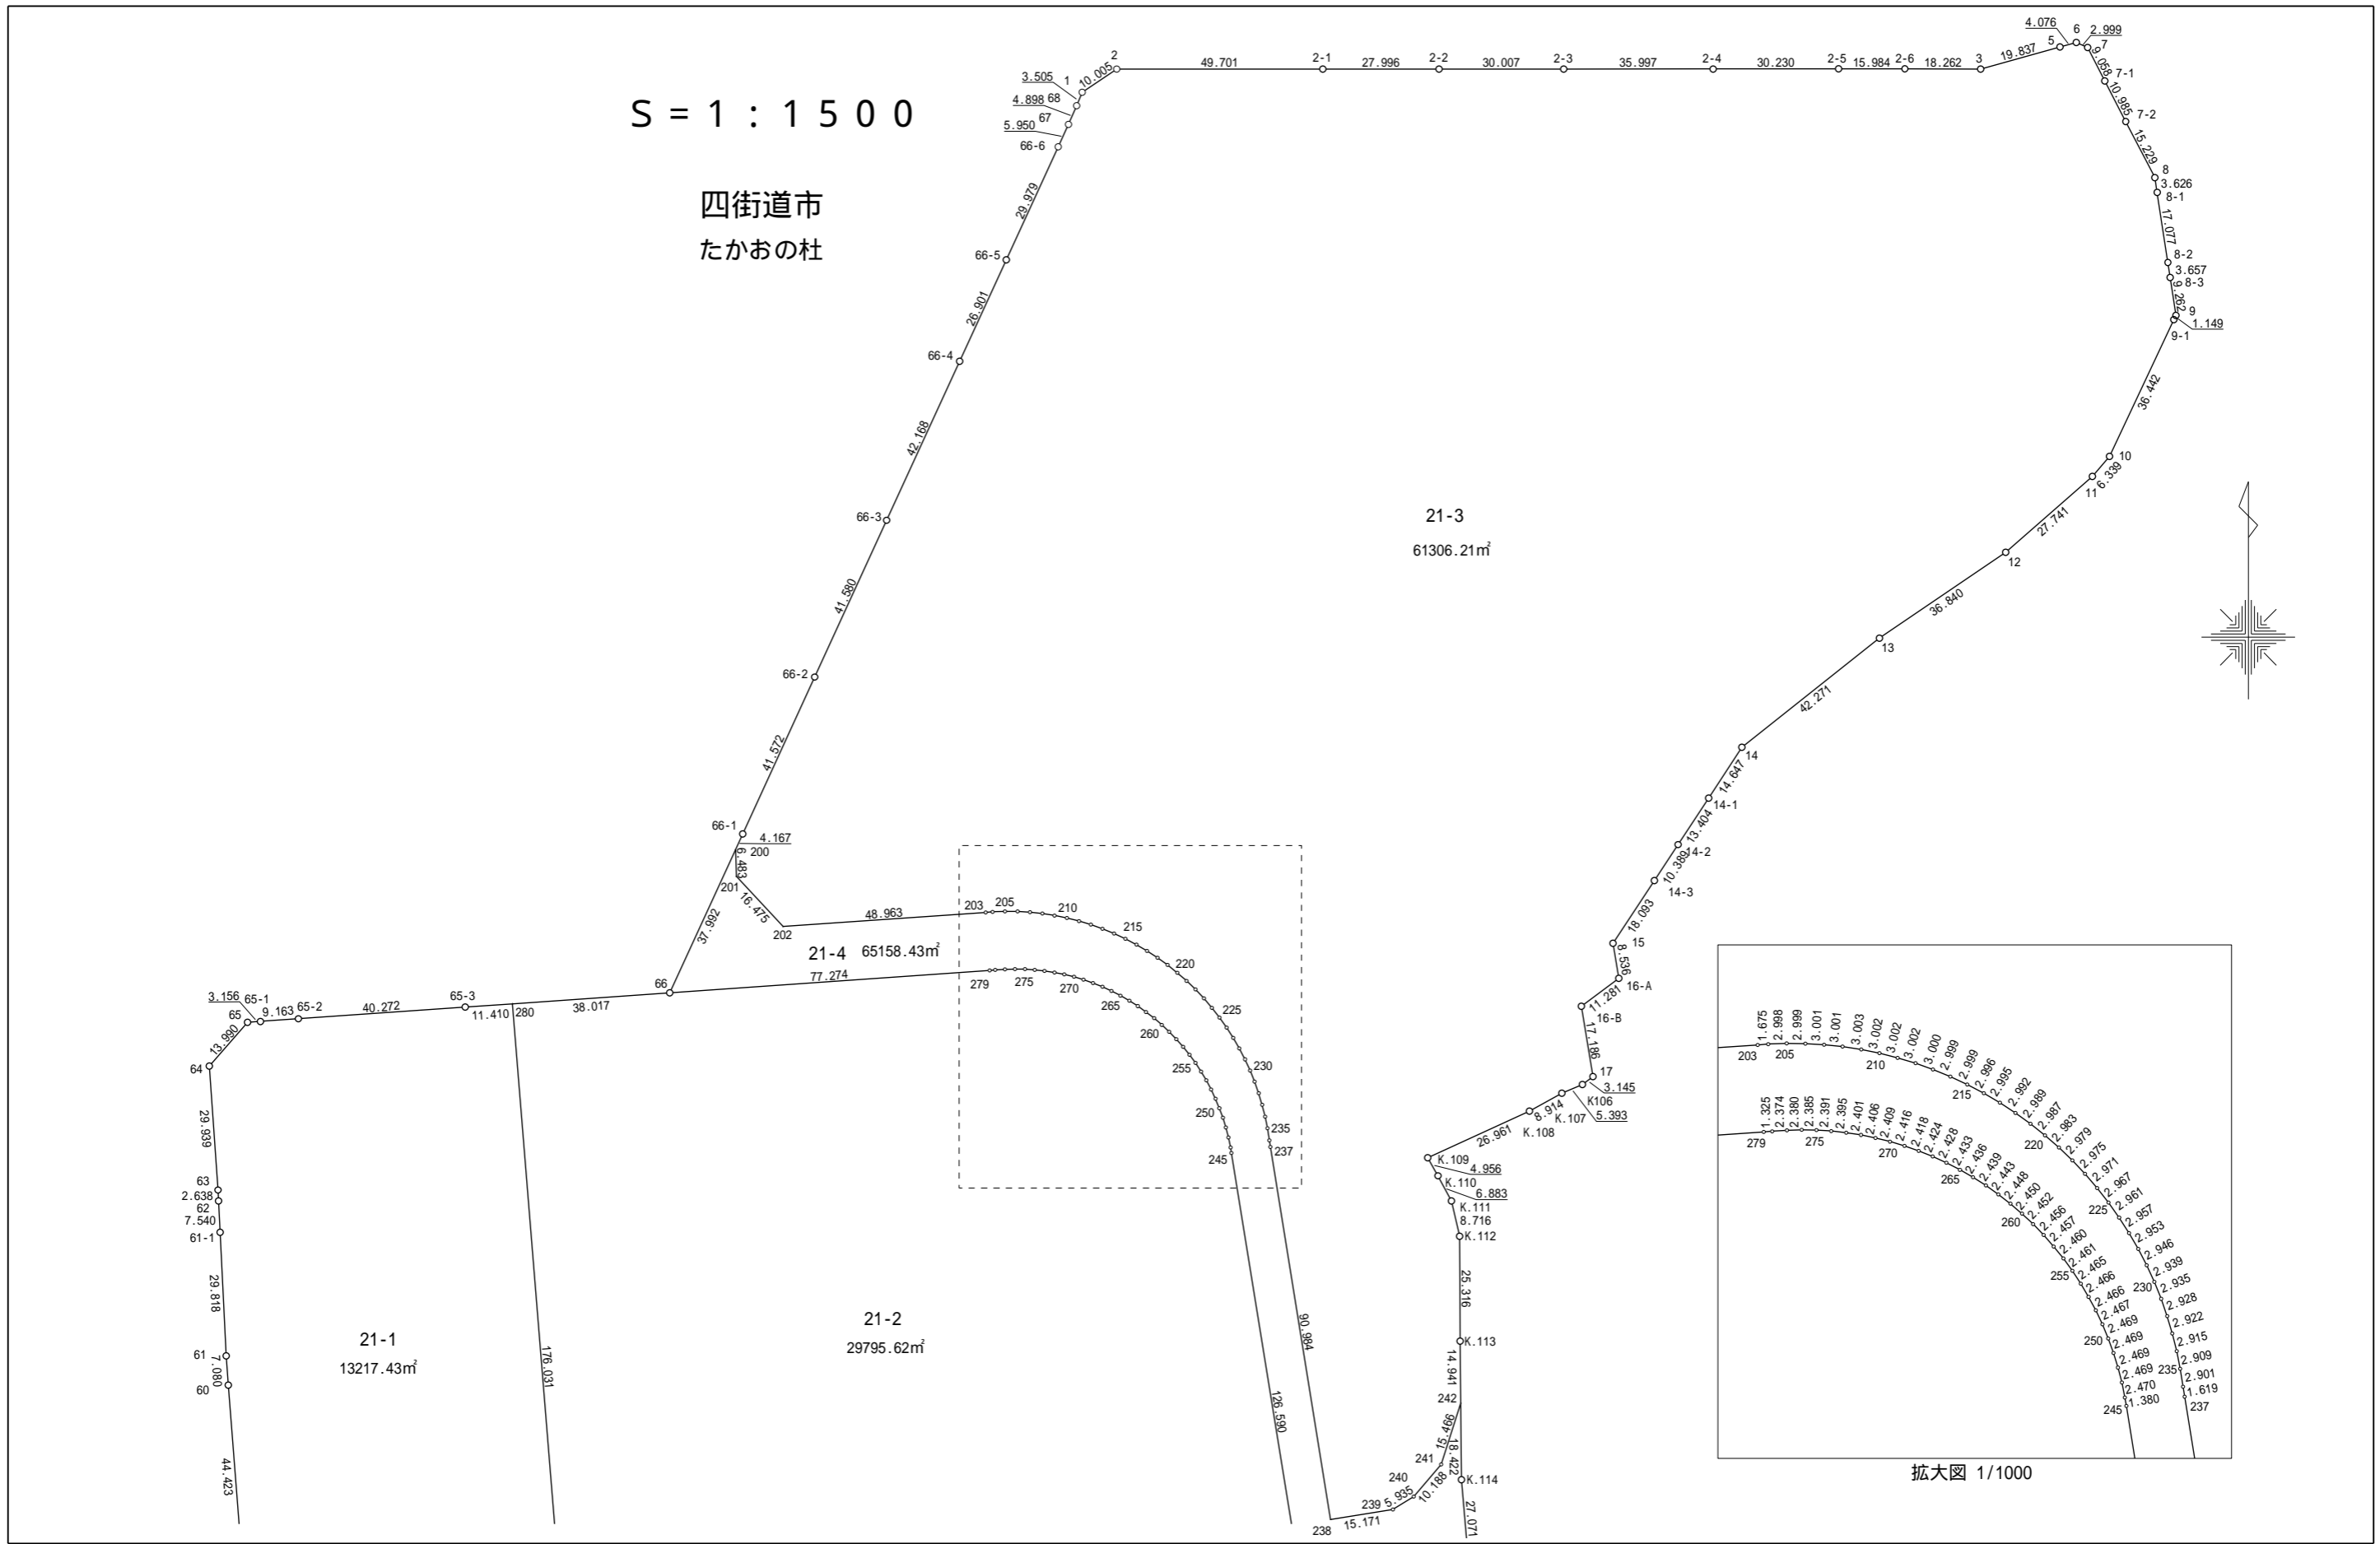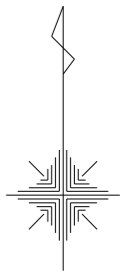

画地出来形図

S = 1 : 1500

四街道市
たかおの杜

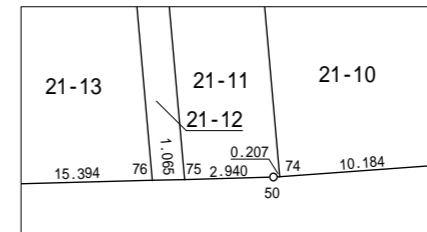
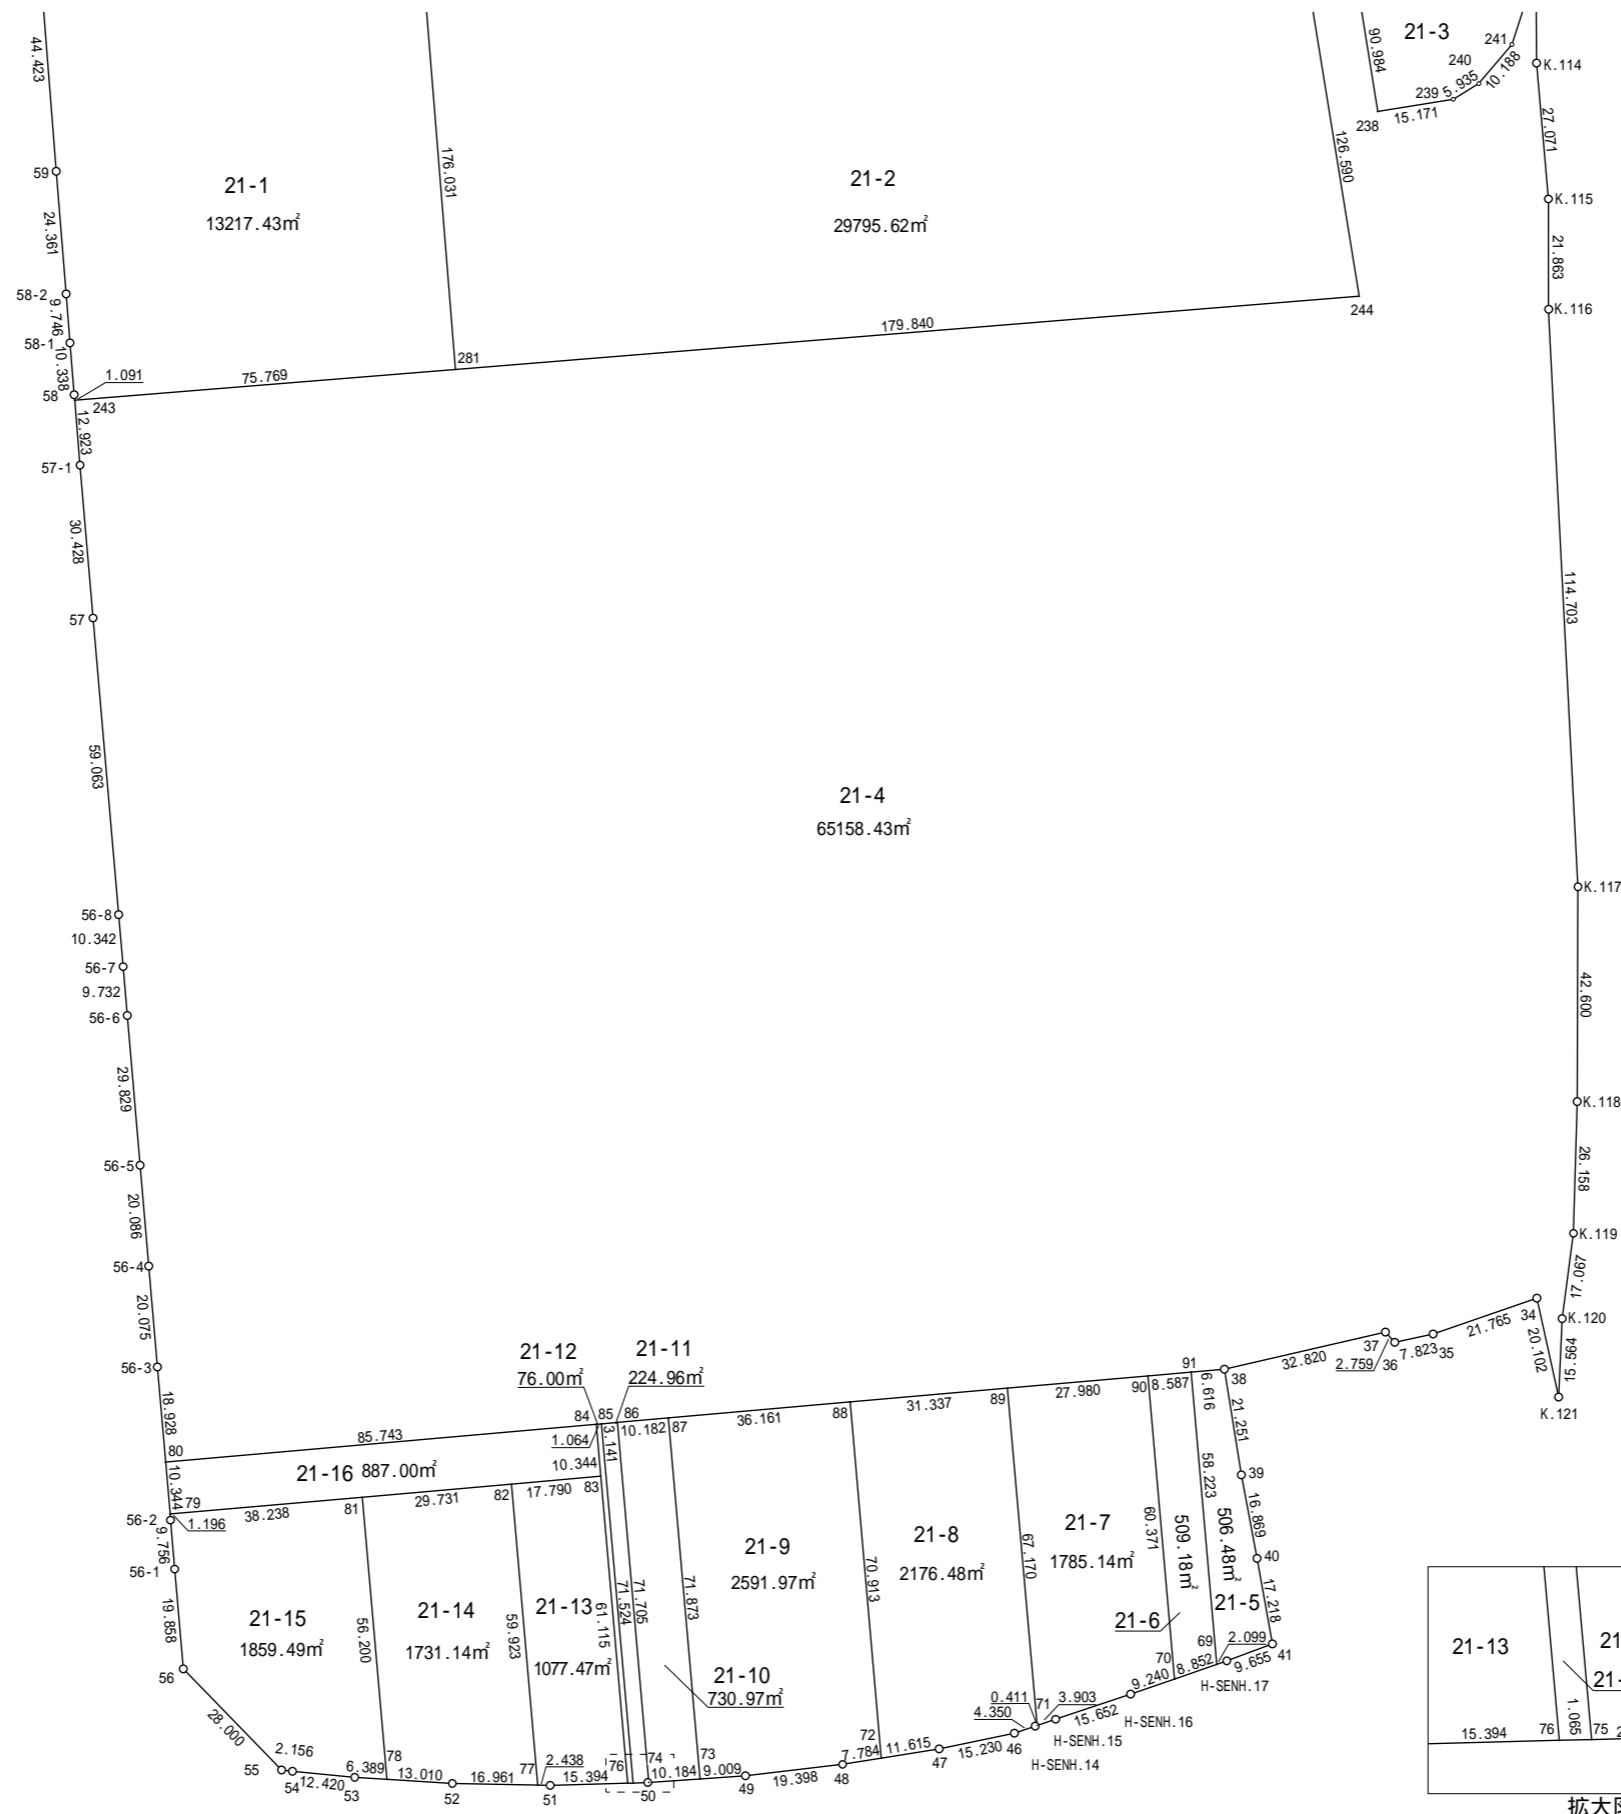
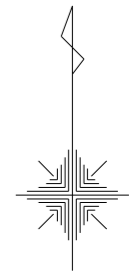


拡大図 1/250

画地出来形図

S = 1 : 500

四街道市
たかおの杜

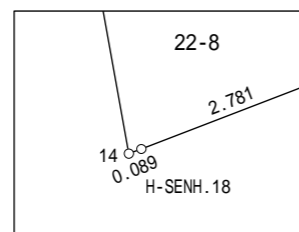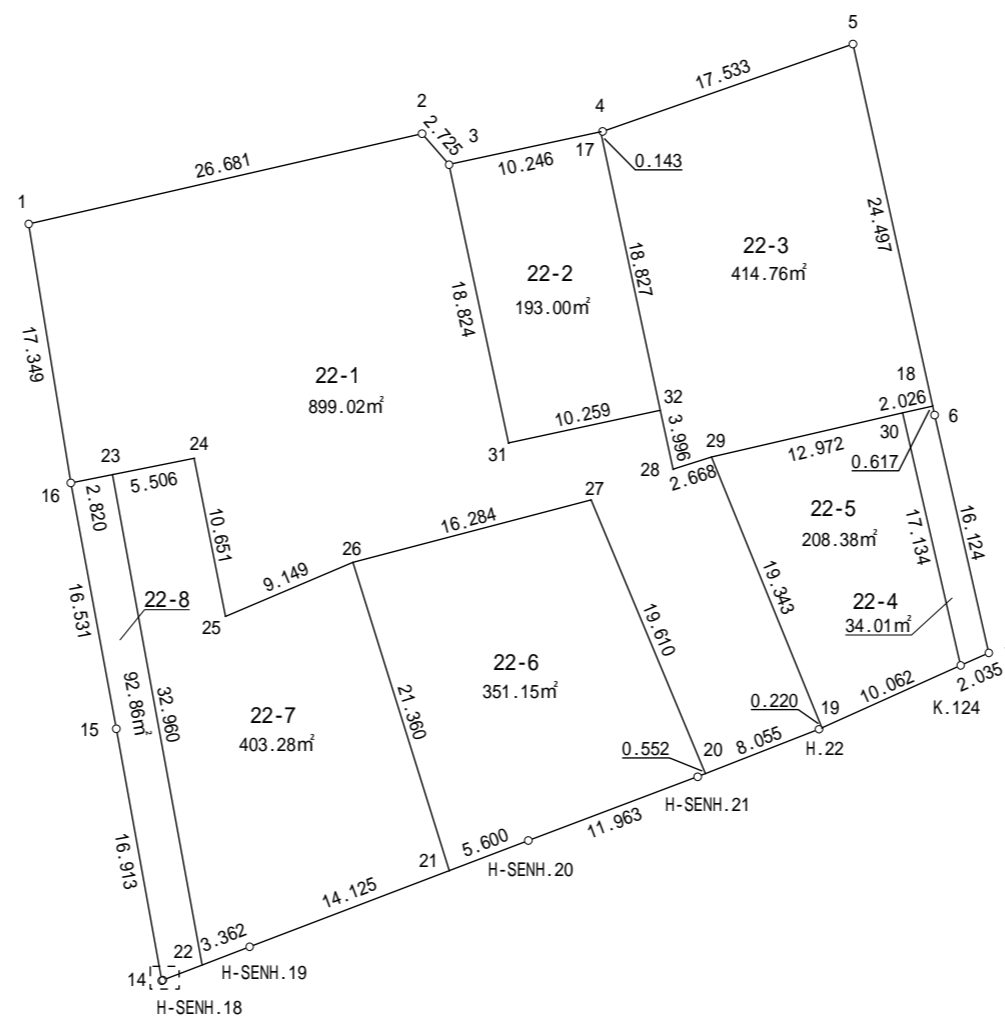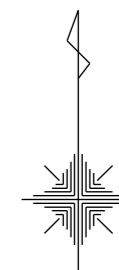

拡大図 1/50